Q1
We intend to follow the clouded opening location & size per Level-9 (refer snap#01), typical at Levels 9–11.Please confirm.

Q2
We intend to follow the clouded opening location & size per Level-9r (refer snap#02), typical at Levels 9 thru Roof.Please confirm.

Q3
We intend to move the cyan highlighted beam 1" towards west to clear the magenta opening.
Please confirm.

Q4
We have moved the green highlighted beam's right end for 1/2" towards east to clear the opening.

Please confirm.

Q5
We intend to follow 7'-2 1/2" from Grid C' as shown in level-10 (typical at Levels 9–11). Please confirm.

SNAP#01 FROM 1/A057

SNAP#02 FROM 1/A057

SNAP#03 FROM S135_B

SNAP#04 FROM S135_D

2 SLAB EDGE - LEVEL 10
A057 1" = 20'-0"

1 SLAB EDGE - LEVEL 09
A057 1" = 20'-0"

NEW FLOOR STEEL STRUCTURE NOTES:

1. SEE STRUCTURAL DRAWINGS FOR STEEL SIZING & LOCATIONS
2. NEW STEEL COLUMNS ALIGNED W/ EXISTING CONCRETE COLUMNS BELOW UNLESS NOTED OTHERWISE. DIMENSIONS PROVIDED FOR COLUMNS NOT ALIGNED W/ BELOW.
3. SEE STRUCTURAL DRAWINGS FOR STEEL COLUMN SIZING & SHAPE. RECTANGULAR GRAPHIC SHOWN IN ARCHITECTURAL PLANS ALSO REPRESENTS GYPSUM FURRING NEEDED FOR RATING.

LEGEND
- NEW STEEL COLUMN, ALIGNED WITH COLUMN BELOW
- NEW STEEL COLUMN SUPPORTED BY BEAM BELOW, SEE DIMENSIONS

SLAB EDGE DRAWING NOTES:

1. SLAB DRAWINGS ARE BASED ON ORIGINAL EXISTING DRAWINGS. ALL LOCATIONS & DIMENSIONS TO BE VERIFIED IN FIELD. CONTRACTOR TO NOTIFY ARCHITECT OF ANY OPENINGS NOT SHOWN ON DRAWINGS. OPE… INFILL.
2. SEE DEMOLITION… NEW OPENINGS… DEMOLITION, & S… ARE TO BE CUT …
3. SEE ADDITIONAL… DEMOLITION DRA… ELEVATOR PITS …
4. NEW INFILLS AT … EXTENSIONS ARE… ADJACENT SLAB… NOTED OTHERW…
5. SEE A06# SERIE… PERIMETER PLAN… PERIMETER OMMITED FROM THIS DRAWING FOR CLARITY.

LEGEND
- EXISTING SLAB, TO REMAIN
- NEW SLAB, …

SK#43
05 page's
16 **Queries**
Date: 09-09-2025

DOB STAMP

1250 Maryland Avenue
1250 MARYLAND AVENUE SW
WASHINGTON, DC 20024

BEYER BLINDER BELLE
3307 M Street Northwest, Suite 301
Washington, DC, 20007
202 333 8000

MECHANICAL & PLUMBING
HURST ENGINEERS
703-534-7872

ELECTRICAL
POWER DESIGN INC.
727-497-9811

STRUCTURAL
RATHGEBER GOSS ASSOCIATES
301-590-0071

CIVIL
GORDON DC
202-869-1600

LANDSCAPE
OVS
202-546-7575

INTERIORS
KTGY SDDG
312-274-0707

LIGHTING
CM KLING + ASSOCIATES
703-684-6270

KEY PLAN

STAMP

NO	DATE	DESCRIPTION
5	8/29/25	BULLETIN 1
4	6/6/25	ISSUED FOR CONSTRUCTION
2	Date5	ADDENDUM 02

REVISIONS

SUBMITTAL

BULLETIN 1

DRAWING TITLE
SLAB EDGE - LEVEL 09 TO 10

SCALE	As indicated
DATE	08/29/25
PROJECT NUMBER	6415.00
DRAWING NUMBER	A057

of

NOTE: IF THIS SHEET IS NOT 30"W X 42"D, THEN IT IS NOT THE INTENDED SIZE. IN ALL CASES, WORK TO FIGURED DIMENSIONS.

0 0.5' 1' 2'

Q6

The highlighted location graphically shows an opening or pad, However, there are no details shown in mechanical or structural drawings at this location. Therefore, we have ignored this green highlighted opening.

Please advise.

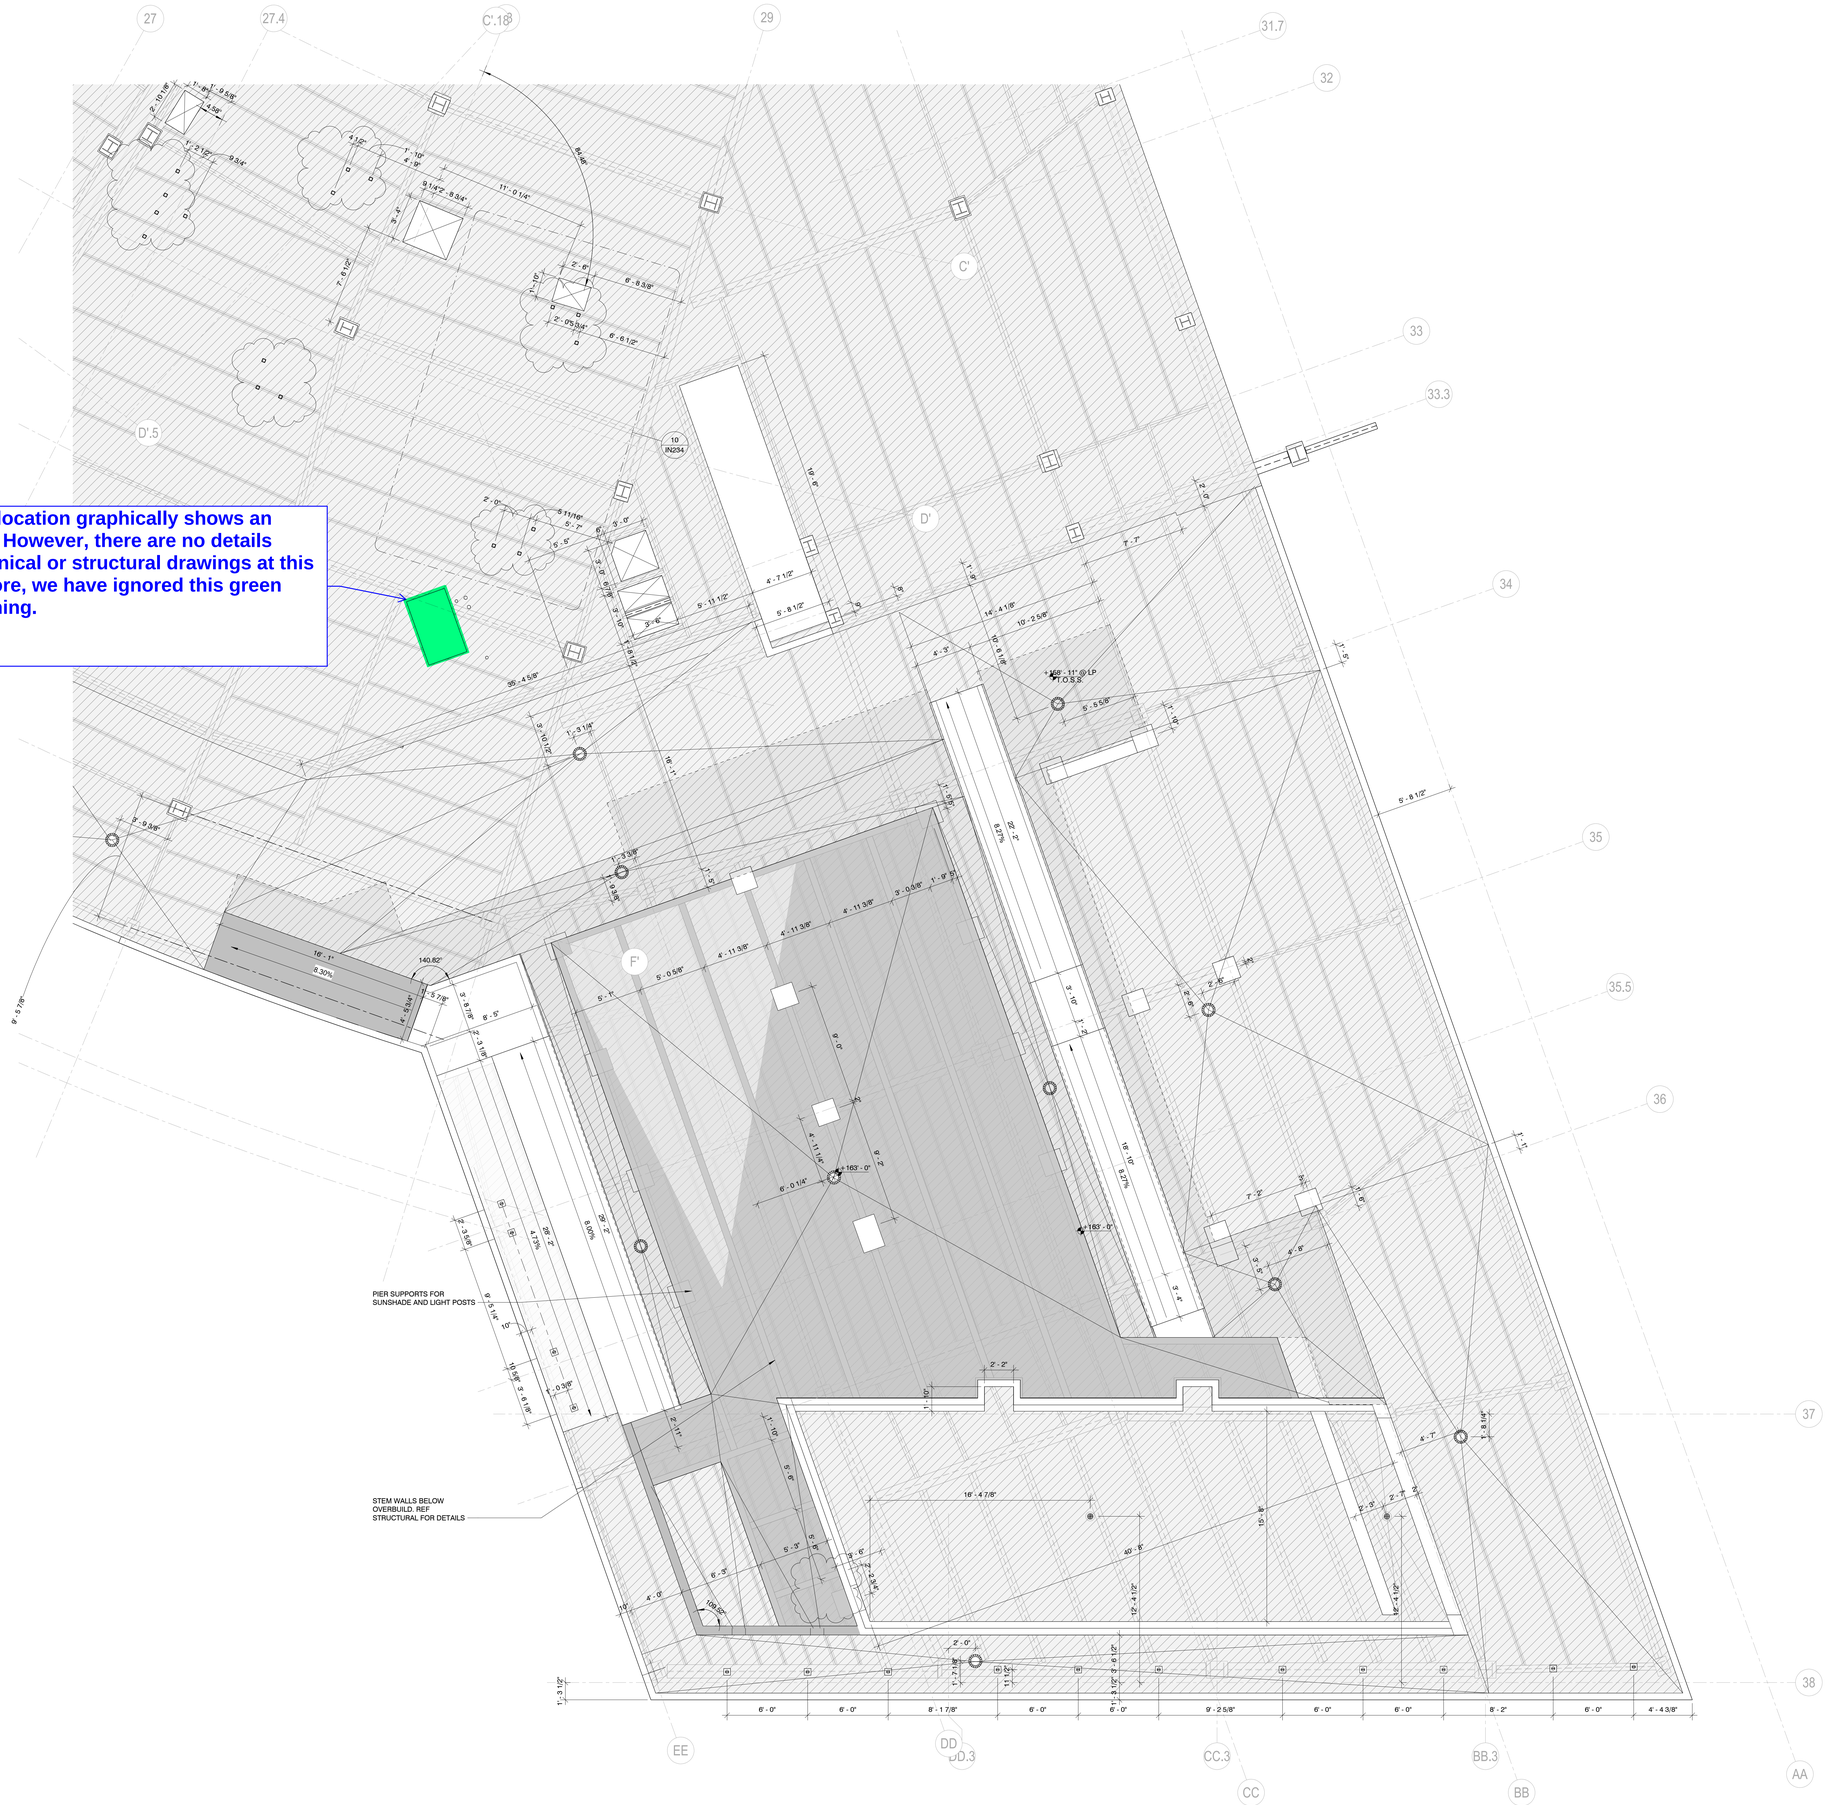

1 A071 SLAB EDGE - ENLARGED PLAN LEVEL 11
1/4" = 1'-0"

DOB STAMP

1250 Maryland Avenue
1250 MARYLAND AVENUE SW
WASHINGTON, DC 20024

BEYER BLINDER BELLE
3307 M Street Northwest, Suite 301
Washington, DC, 20007
202 333 8000

MECHANICAL & PLUMBING
HURST ENGINEERS
703-534-7872

ELECTRICAL
POWER DESIGN INC.
727-497-9811

STRUCTURAL
RATHGEBER GOSS ASSOCIATES
301-590-0071

CIVIL
GORDON DC
202-869-1600

LANDSCAPE
OVS
202-546-7575

INTERIORS
KTGY SDDG
312-274-0707

LIGHTING
CM KLING + ASSOCIATES
703-684-6270

KEY PLAN

STAMP

NO	DATE	DESCRIPTION
4	6/6/25	ISSUED FOR CONSTRUCTION

REVISIONS

SUBMITTAL

ISSUED FOR CONSTRUCTION

DRAWING TITLE

ENLARGED SLAB EDGE PLANS

SCALE	1/4" = 1'-0"
DATE	05/16/25
PROJECT NUMBER	6415.00
DRAWING NUMBER	A071

of

Autodesk Docs://6415 - 1250 Maryland Avenue/KA415-1250 Maryland Ave-R24.rvt

6/5/2025 5:06:17 PM

NOTE: IF THIS SHEET IS NOT 36"W x 48"D THEN IT IS NOT THE INTENDED SIZE. IN ALL CASES, WORK TO FIGURED DIMENSIONS.

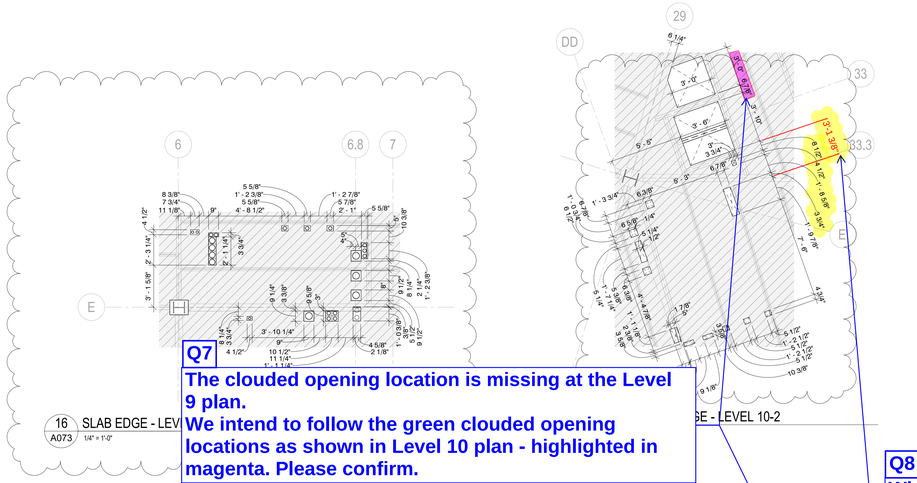

16 SLAB EDGE - LEVEL 10-2
A073 1/4" = 1'-0"

Q7
The clouded opening location is missing at the Level 9 plan.
We intend to follow the green clouded opening locations as shown in Level 10 plan - highlighted in magenta. Please confirm.

Q8
While comparing Level-09 (green highlighted) and Level-10 (yellow highlighted)SUM of opening dimensions from Grid '33.3' shows different values. Therefore, we have followed the Level-09 opening dimension and ignored level-10 dimensions. Please confirm.

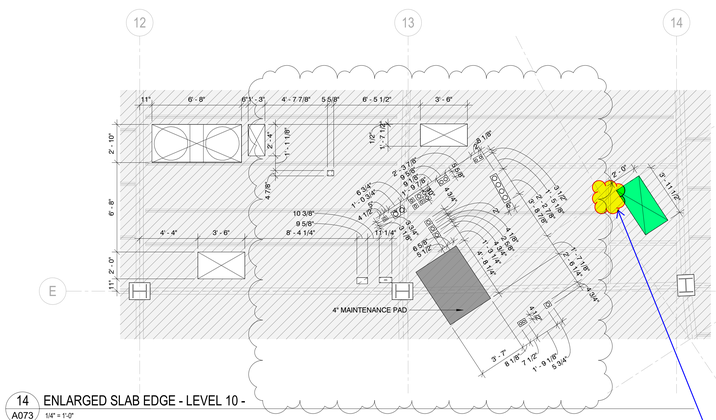

14 ENLARGED SLAB EDGE - LEVEL 10 -
A073 1/4" = 1'-0"

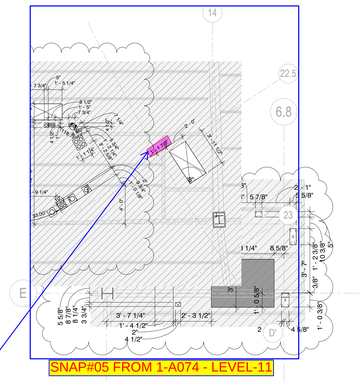

SNAP#05 FROM 1-A074 - LEVEL-11

13 ENLARGED SLAB EDGE - LEVEL 10
A073 1/4" = 1'-0"

Q9
We intend to use the magenta highlighted dimension(shown in Level-11) for the level 9 & level10 since the level 9 & 10 plans doesn't shows the same.

Q10
Please provide the missing ('?') dimension

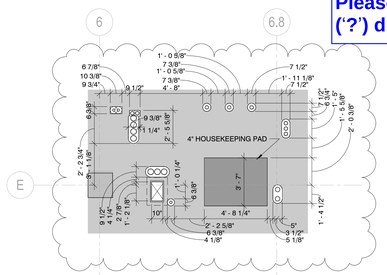

12 ENLARGED SLAB EDGE - LEVEL 08
A073 1/4" = 1'-0"

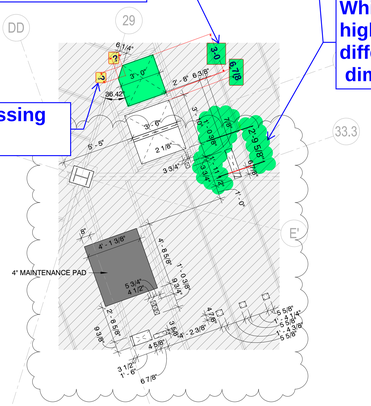

11 ENLARGED SLAB EDGE - LEVEL 9 -3
A073 1/4" = 1'-0"

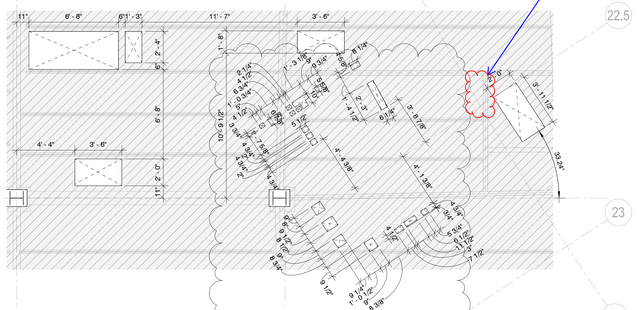

10 ENLARGED SLAB EDGE - LEVEL 9 -2 (LEVEL 10 SIM)
A073 1/4" = 1'-0"

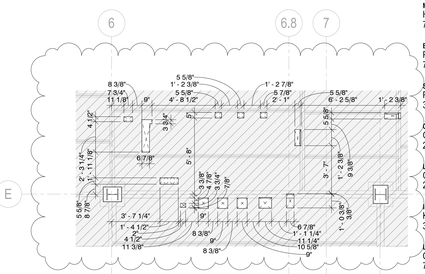

9 ENLARGED SLAB EDGE - LEVEL 9-1 (LEVEL 11 SIM)
A073 1/4" = 1'-0"

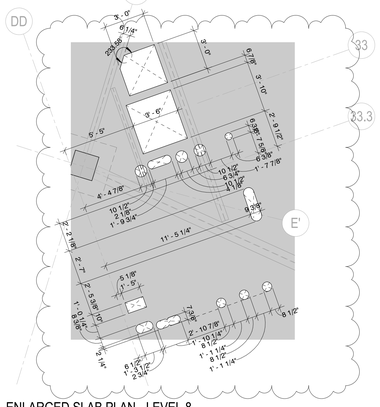

8 ENLARGED SLAB PLAN - LEVEL 8
A073 1/4" = 1'-0"

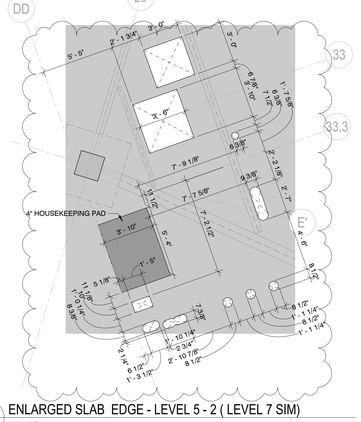

7 ENLARGED SLAB EDGE - LEVEL 5 - 2 (LEVEL 7 SIM)
A073 1/4" = 1'-0"

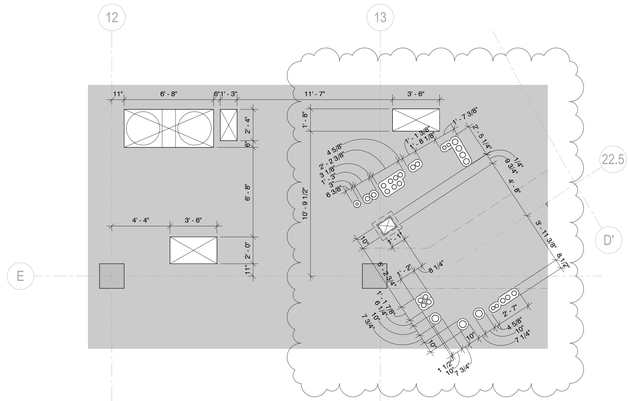

6 ENLARGED SLAB EDGE - LEVEL 05 (LEVEL 7 SIM)
A073 1/4" = 1'-0"

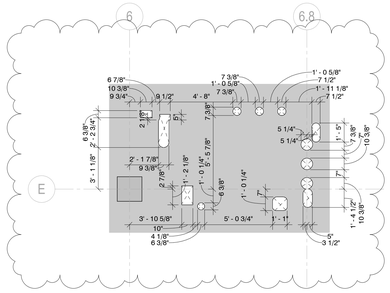

5 ENLARGED SLAB EDGE - LEVEL 5 - 1 (LEVEL 7 SIM)
A073 1/4" = 1'-0"

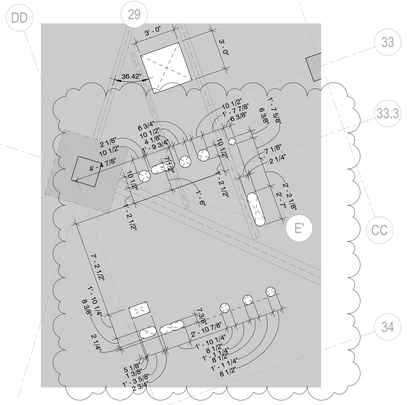

3 ENLARGED SLAB EDGE - LEVEL 4 - 3 (LEVEL 6 SIM)
A073 1/4" = 1'-0"

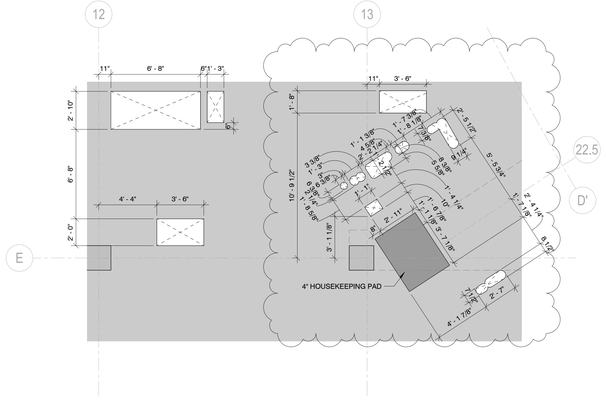

2 ENLARGED SLAB EDGE - LEVEL 4 - 2 (LEVELS 5, 6, 7, & 8 SIM)
A073 1/4" = 1'-0"

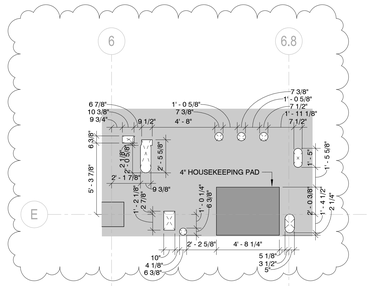

1 ENLARGED SLAB EDGE - LEVEL 4 - 1 (LEVELS 6 & 8 SIM)
A073 1/4" = 1'-0"

DOB STAMP

1250 Maryland Avenue
1250 MARYLAND AVENUE SW
WASHINGTON, DC 20024

BEYER BLINDER BELLE
3307 M Street Northwest, Suite 301
Washington, DC, 20007
202 333 8000

MECHANICAL & PLUMBING
HURST ENGINEERS
703-534-7872

ELECTRICAL
POWER DESIGN INC.
727-497-9811

STRUCTURAL
RATHGEBER GOSS ASSOCIATES
301-590-0071

CIVIL
GORDON DC
202-869-1600

LANDSCAPE
OVS
202-546-7575

INTERIORS
KTGY SDDG
312-274-0707

LIGHTING
CM KLING + ASSOCIATES
703-684-6270

KEY PLAN

STAMP

NO	DATE	DESCRIPTION
5	8/29/25	BULLETIN 1

REVISIONS

SUBMITTAL

BULLETIN 1

DRAWING TITLE

ENLARGED SLAB EDGE PENETRATIONS PLANS

SCALE	1/4" = 1'-0"
DATE	08/29/25
PROJECT NUMBER	6415.00
DRAWING NUMBER	A073

of

8/29/2025 1:18:01 PM Autodesk Docs://6415 - 1250 Maryland Avenue/WX415-1250 Maryland Ave.rvt

NOTE: IF THIS SHEET IS NOT 30"W x 42"D, THEN IT IS NOT THE INTENDED SIZE. IN ALL CASES, WORK TO FIGURED DIMENSIONS.

Q11

From level-9 thru level 11, Plan drawings shows the same locating dimension for the magenta clouded opening but the locating dimension differs at Roof level.

please advise.

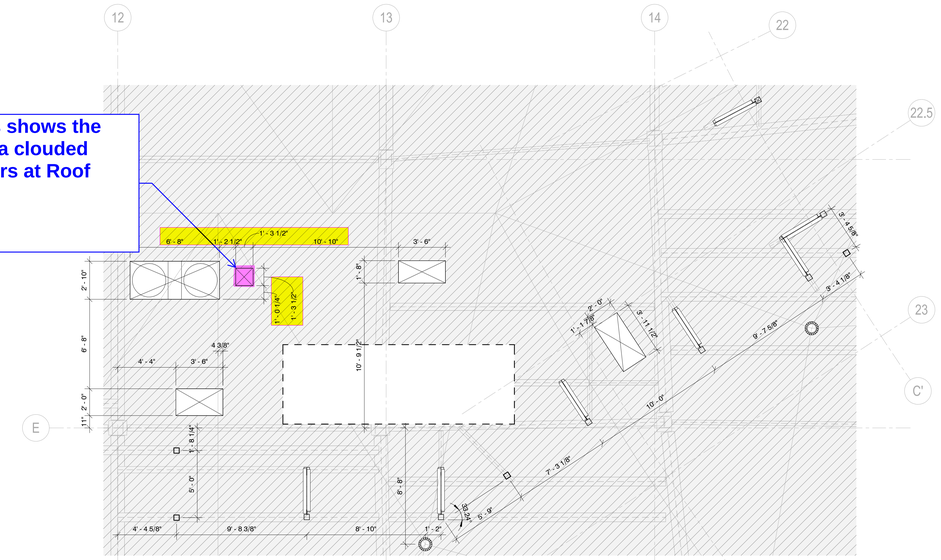

4 SLAB EDGE - ROOF - Callout 3
A074 1/4" = 1'-0"

Q12

We intend to move the cyan highlighted beam 1" towards SOUTH to clear the magenta opening. Please confirm.

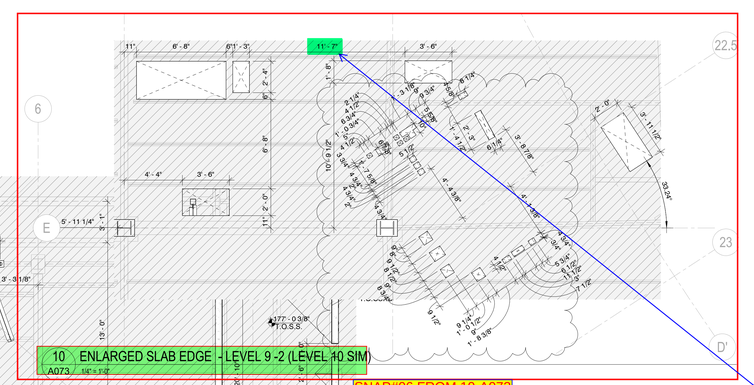

10 ENLARGED SLAB EDGE - LEVEL 9 -2 (LEVEL 10 SIM)
A073 1/4" = 1'-0"

SNAP#06 FROM 10-A073

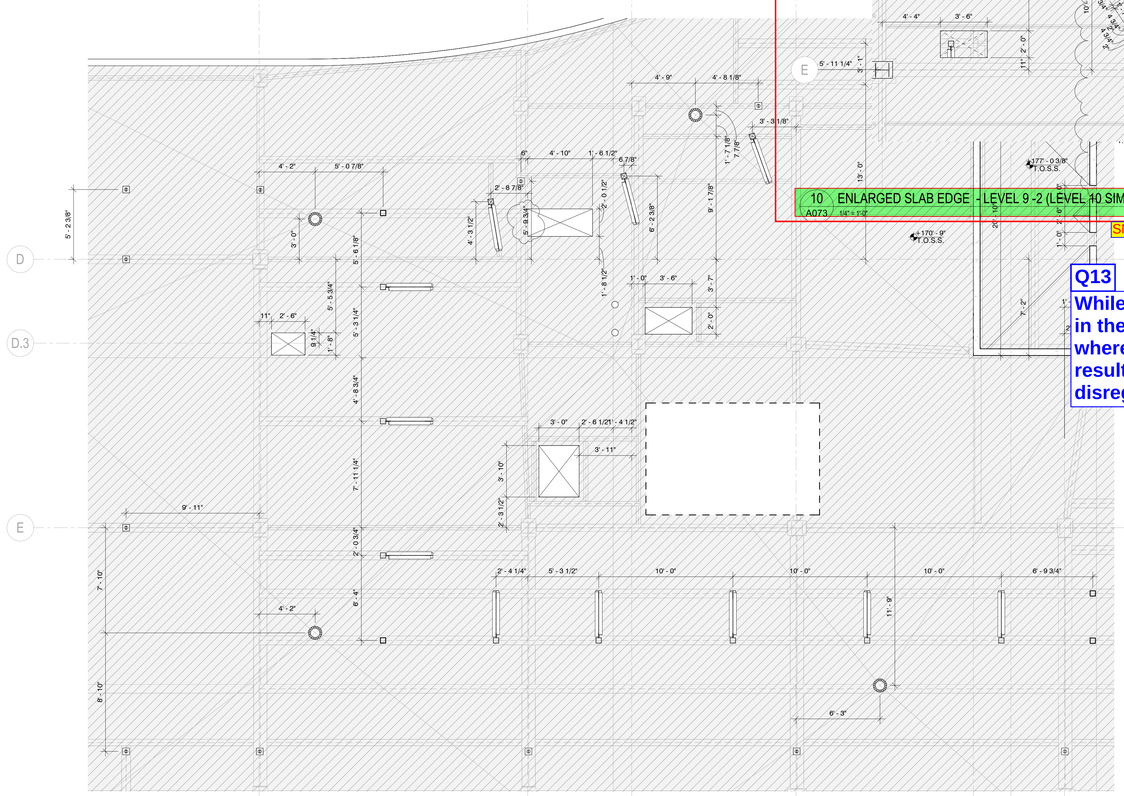

2 SLAB EDGE - ROOF - Callout 1
A074 1/4" = 1'-0"

Q13

While adding the clouded dimension, we observed a conflict in the opening location. Level 9 shows 11'-7"(see snap#06), whereas the yellow clouded area reflects 11'-7 1/8", resulting in a 1/8" discrepancy. Please confirm if we should disregard the variation and follow the Level 9 dimension?

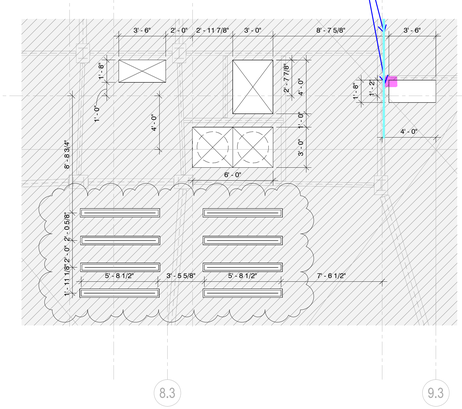

3 SLAB EDGE - ROOF - Callout 2
A074 1/4" = 1'-0"

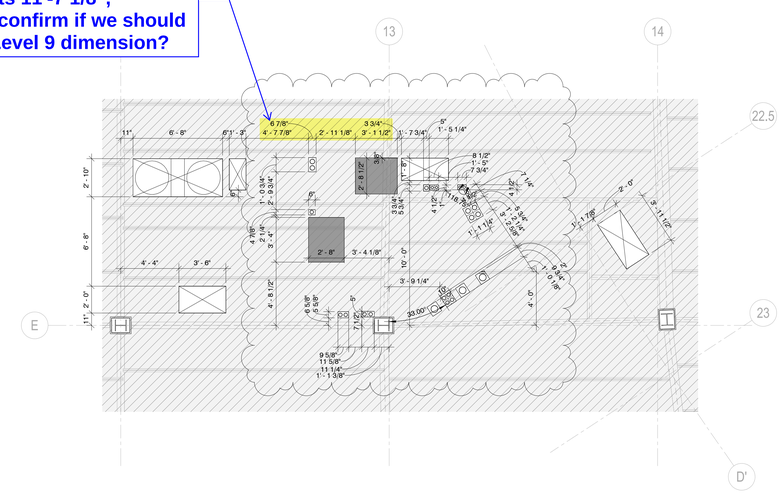

1 SLAB EDGE - LEVEL 11 - Callout 1
A074 1/4" = 1'-0"

DOB STAMP

1250 Maryland Avenue
1250 MARYLAND AVENUE SW
WASHINGTON, DC 20024

BEYER BLINDER BELLE
3307 M Street Northwest, Suite 301
Washington, DC, 20007
202 333 8000

MECHANICAL & PLUMBING
HURST ENGINEERS
703-534-7872

ELECTRICAL
POWER DESIGN INC.
727-497-9811

STRUCTURAL
RATHGEBBER GOSS ASSOCIATES
301-590-0071

CIVIL
GORDON DC
202-869-1600

LANDSCAPE
OVS
202-546-7575

INTERIORS
KTGY SDDG
312-274-0707

LIGHTING
CM KLING + ASSOCIATES
703-684-6270

KEY PLAN

STAMP

NO	DATE	DESCRIPTION
5	8/29/25	BULLETIN 1

REVISIONS

SUBMITTAL

BULLETIN 1

DRAWING TITLE

ENLARGED SLAB EDGE PENETRATIONS PLANS

SCALE	1/4" = 1'-0"
DATE	08/29/25
PROJECT NUMBER	6415.00
DRAWING NUMBER	A074

of

NOTE IF THIS SHEET IS NOT 30"W x 42"D
THEN IT IS NOT THE INTENDED SIZE. IN ALL
CASES, WORK TO FIGURED DIMENSIONS.

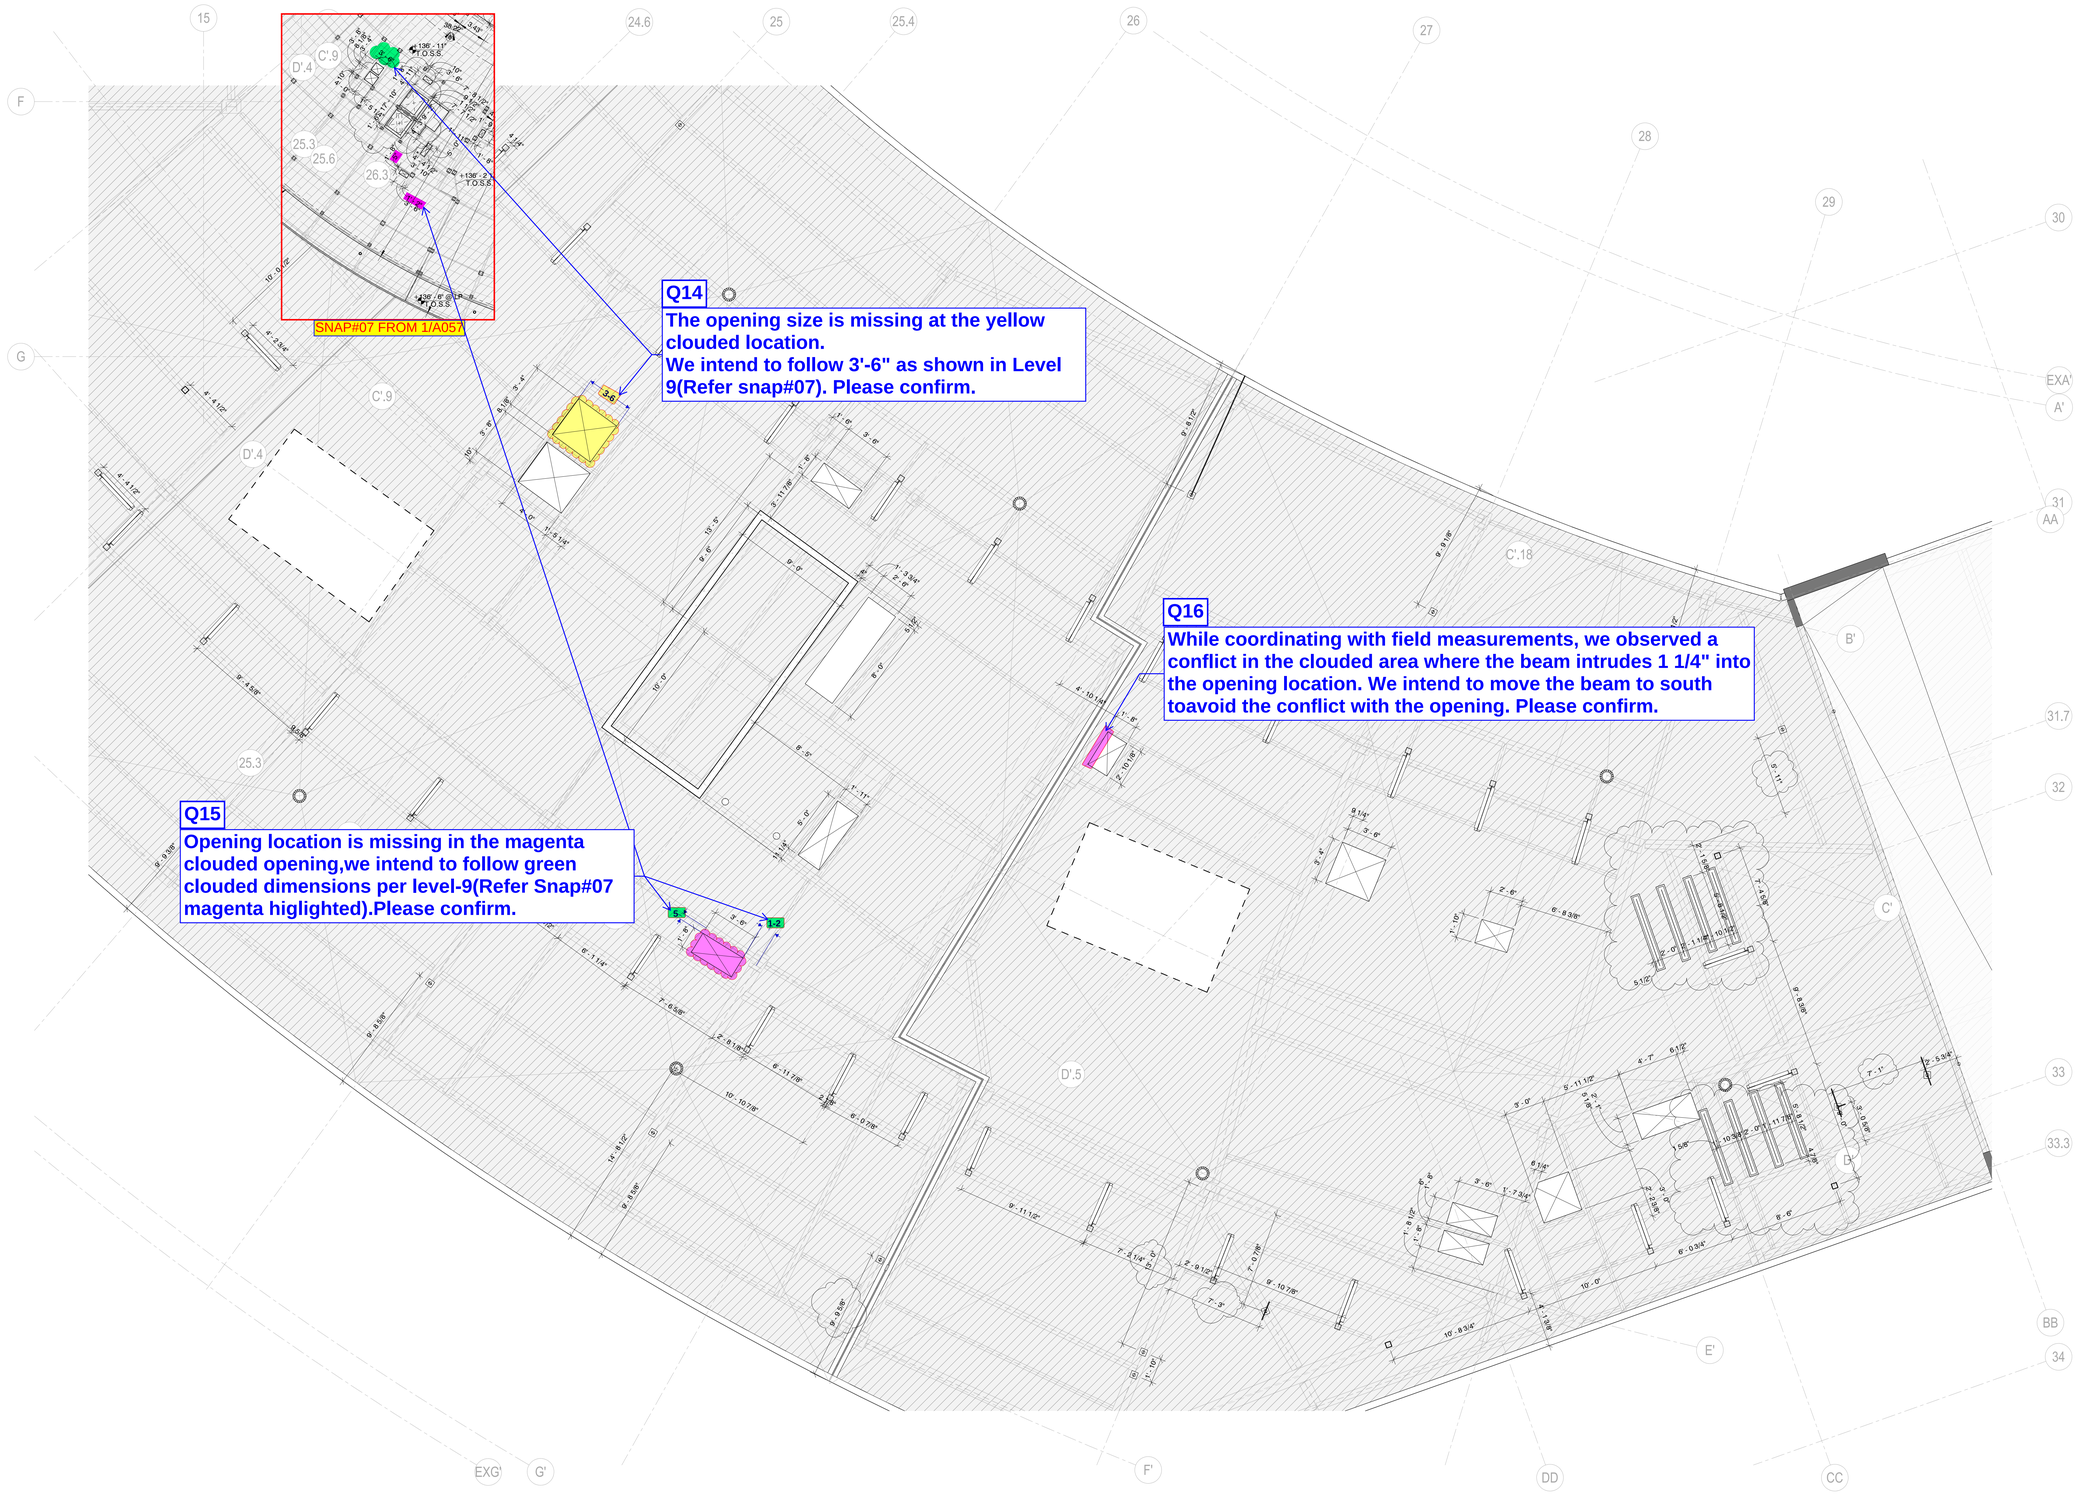

1 A075 SLAB EDGE - ROOF - Callout 4
1/4" = 1'-0"

DOB STAMP

1250 Maryland Avenue
1250 MARYLAND AVENUE SW
WASHINGTON, DC 20024

BEYER BLINDER BELLE
3307 M Street Northwest, Suite 301
Washington, DC, 20007
202 333 8000

MECHANICAL & PLUMBING
HURST ENGINEERS
703-534-7872

ELECTRICAL
POWER DESIGN INC.
727-497-9811

STRUCTURAL
RATHGEBER GOSS ASSOCIATES
301-590-0071

CIVIL
GORDON DC
202-869-1600

LANDSCAPE
OVS
202-546-7575

INTERIORS
KTGY SDDG
312-274-0707

LIGHTING
CM KLING + ASSOCIATES
703-684-6270

KEY PLAN

STAMP

NO	DATE	DESCRIPTION
5	8/29/25	BULLETIN 1

REVISIONS

SUBMITTAL

BULLETIN 1

DRAWING TITLE

ENLARGED SLAB EDGE PENETRATION PLANS

SCALE	1/4" = 1'-0"
DATE	08/29/25
PROJECT NUMBER	6415.00

DRAWING NUMBER

A075

of

8/29/2025 11:19:09 PM
Autodesk Docs://6415 - 1250 Maryland Avenue/A/6415-1250 Maryland Ave-R24.rvt