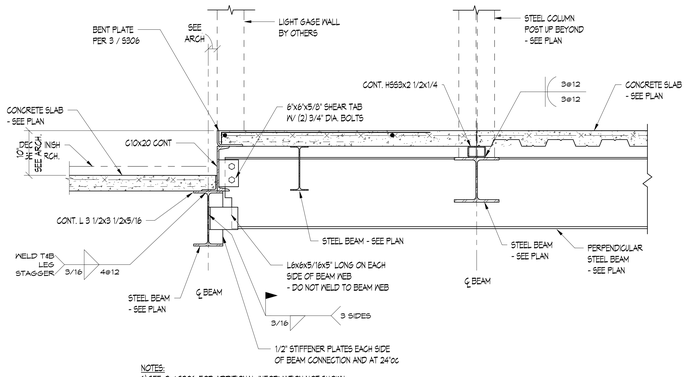

NOTES:
1) SEE 3 / S306 FOR ADDITIONAL INFORMATION NOT SHOWN.

1 SECTION
SCALE: 1" = 1'-0"

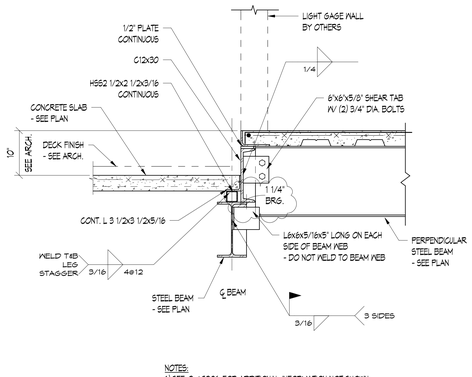

NOTES:
1) SEE 3 / S306 FOR ADDITIONAL INFORMATION NOT SHOWN.

2 SECTION
SCALE: 1" = 1'-0"

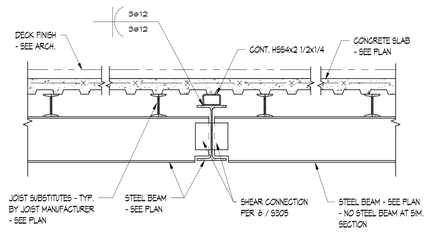

3 SECTION
SCALE: 1" = 1'-0"

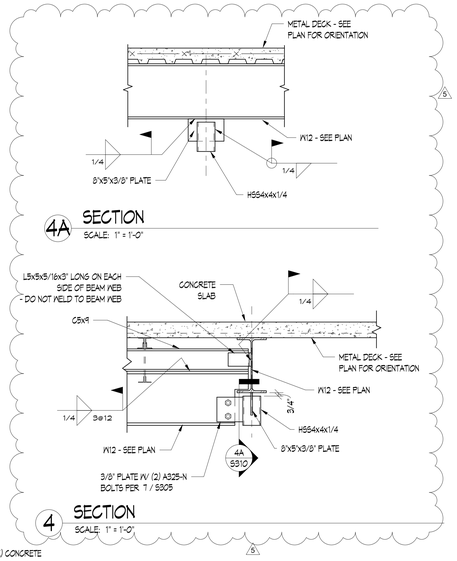

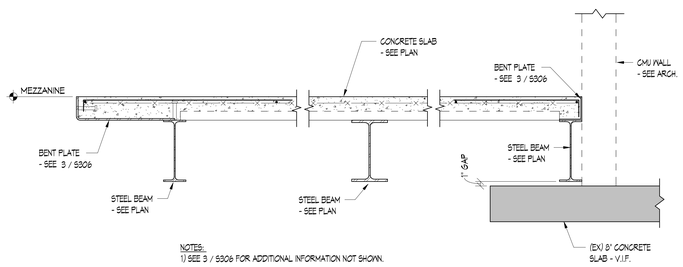

NOTES:
1) SEE 3 / S306 FOR ADDITIONAL INFORMATION NOT SHOWN.

5 SECTION
SCALE: 1" = 1'-0"

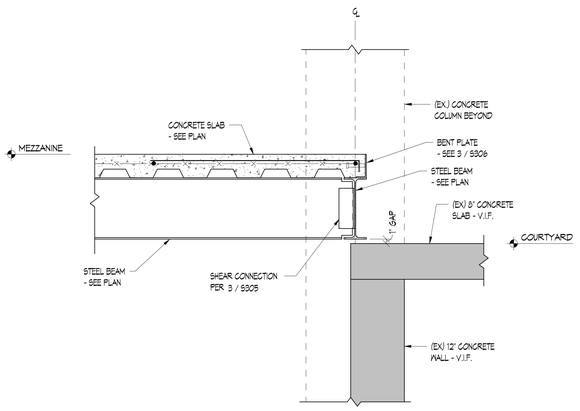

NOTES:
1) SEE 3 / S306 FOR ADDITIONAL INFORMATION NOT SHOWN.

6 SECTION
SCALE: 1" = 1'-0"

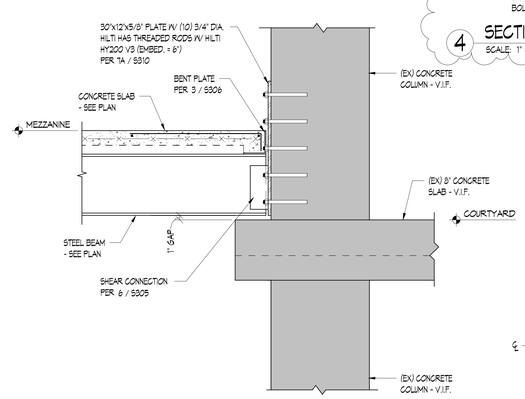

NOTE:
CONTRACTOR TO LOCATE EXISTING REBAR PRIOR TO PLATE FABRICATION DO NOT DRILL THROUGH REBAR.

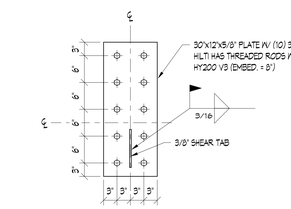

7A SECTION
SCALE: 1" = 1'-0"

7 SECTION
SCALE: 1" = 1'-0"

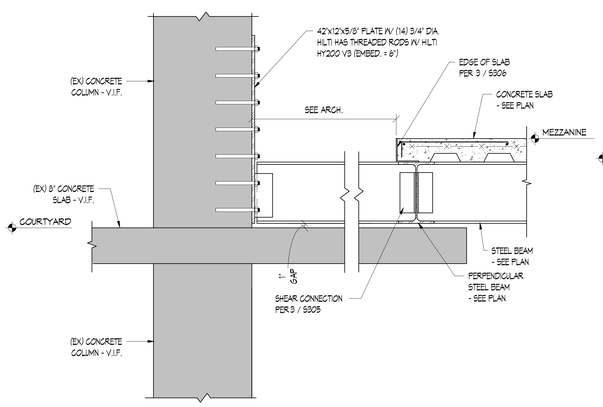

NOTE:
CONTRACTOR TO LOCATE EXISTING REBAR PRIOR TO PLATE FABRICATION DO NOT DRILL THROUGH REBAR.

8 SECTION
SCALE: 1" = 1'-0"

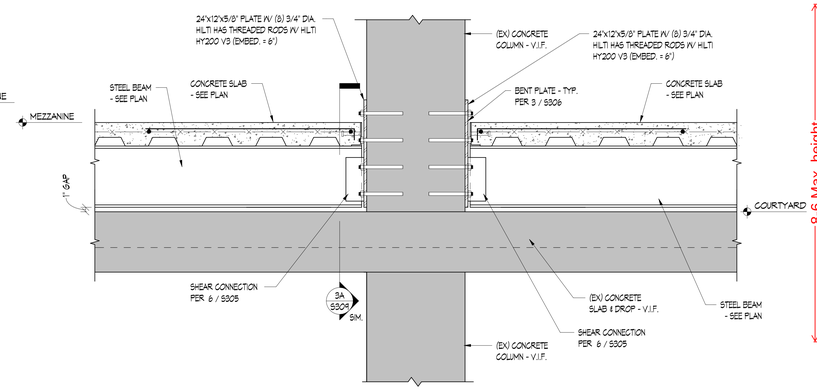

NOTE:
CONTRACTOR TO LOCATE EXISTING REBAR PRIOR TO PLATE FABRICATION DO NOT DRILL THROUGH REBAR.

9 SECTION
SCALE: 1" = 1'-0"

Q1

We intend to make the screen wall steel at yellow highlighted area as one GALVANIZED frame.(see frame height xwidth marked in red)

Please confirm.

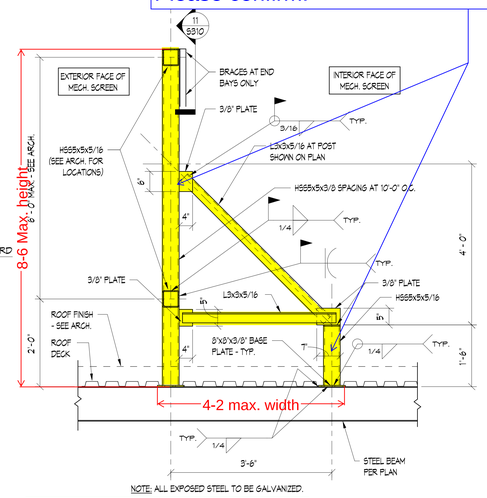

NOTE: ALL EXPOSED STEEL TO BE GALVANIZED.

10 TYPICAL SCREEN WALL DETAIL
SCALE: 3/4" = 1'-0"

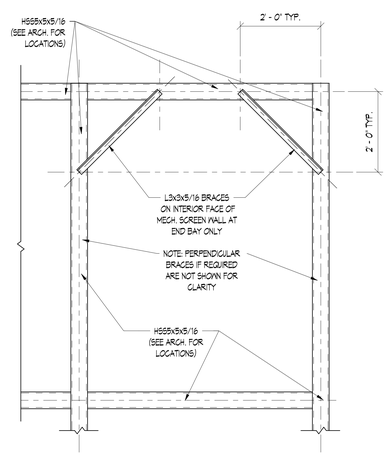

11 TYPICAL MECHANICAL SCREEN BRACING
SCALE: 3/4" = 1'-0"

01 PAGE OF 04

SK#03
04 pages
Date: 04-25-2025

DOB STAMP

1250 Maryland Avenue
1250 MARYLAND AVENUE SW
WASHINGTON, DC 20024

BEYER BLINDER BELLE
3307 M Street Northwest, Suite 301
Washington, DC, 20007
202 333 8000

MECHANICAL & PLUMBING
HURST ENGINEERS
703-534-7872

ELECTRICAL
POWER DESIGN INC.
727-497-9811

STRUCTURAL
RATHGEBBER GOSS ASSOCIATES
301-590-0071

CIVIL
GORDON DC
202-869-1600

LANDSCAPE
OVS
202-546-7575

INTERIORS
KTGY SDDG
312-274-0707

LIGHTING
CM KLING + ASSOCIATES
703-684-6270

KEY PLAN

STAMP

NO	DATE	DESCRIPTION
5	03/14/2025	85% CD
4	02/14/2025	50% CD ADDENDUM 4
3	01/24/2025	50% CD ADDENDUM 3
2	01/15/2025	50% CD ADDENDUM 2
1	12/13/2024	50% CD ADDENDUM 1

REVISIONS

SUBMITTAL
85% CONSTRUCTION DOCUMENTS

DRAWING TITLE
STEEL DETAILS

SCALE	As indicated
DATE	01/24/25
PROJECT NUMBER	6415.00
DRAWING NUMBER	S310

NOTE IF THIS SHEET IS NOT 36"W X 48"L THEN IT IS NOT THE INTENDED SIZE. IN ALL CASES, WORK TO FIGURED DIMENSIONS.

Autodesk Docs://6415 - 1250 Maryland Avenue/S6415-1250 Maryland Ave-R24.rvt

3/13/2025 5:33:38 PM

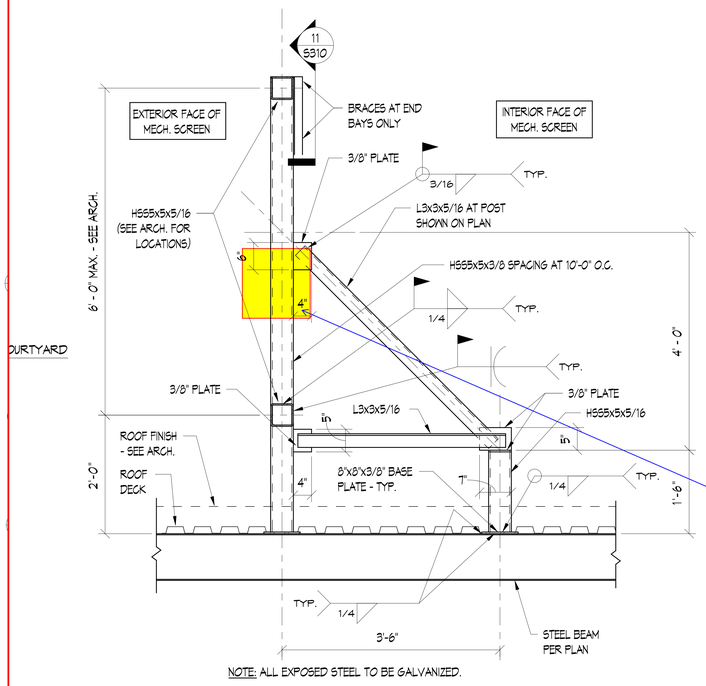

10 TYPICAL SCREEN WALL DETAIL
SCALE: 3/4" = 1'-0"

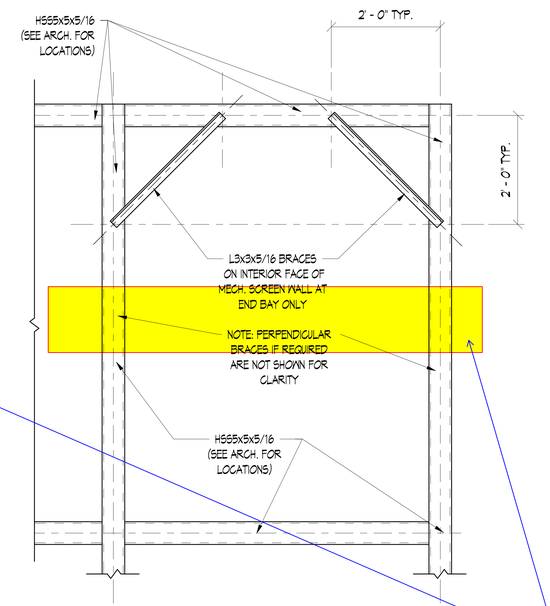

11 TYPICAL MECHANICAL SCREEN BRACING
SCALE: 3/4" = 1'-0"

SNAP FROM 10 & 11/S310

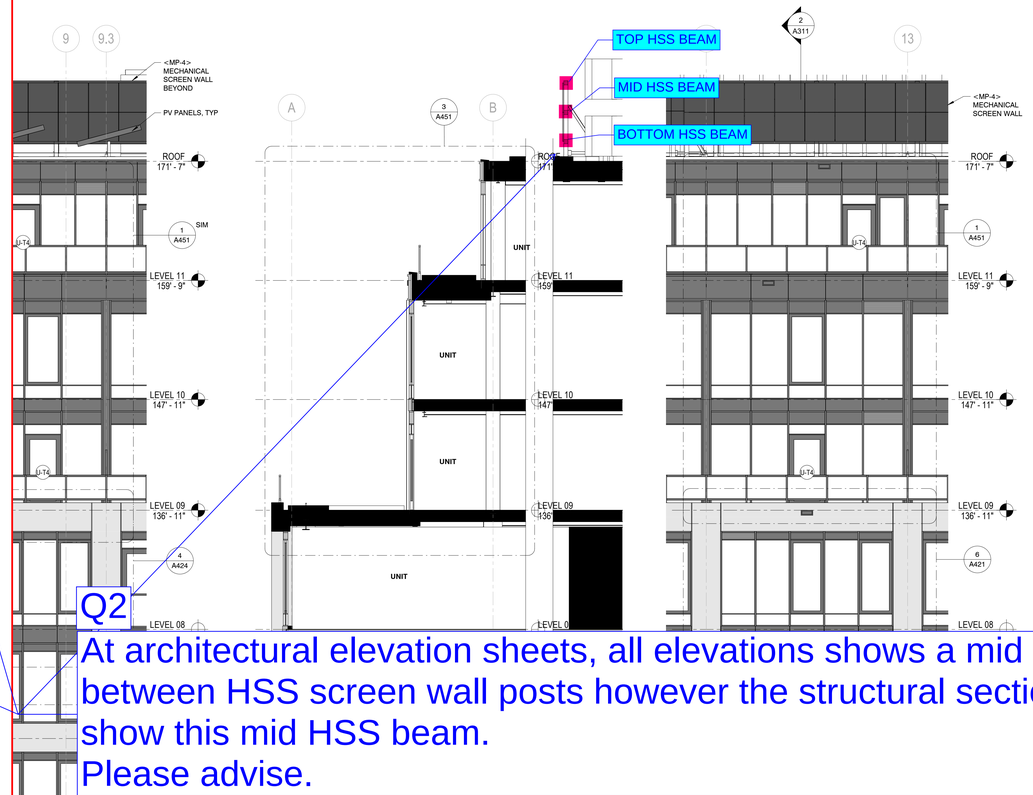

At architectural elevation sheets, all elevations shows a mid HSS run between HSS screen wall posts however the structural sections do not show this mid HSS beam.
Please advise.

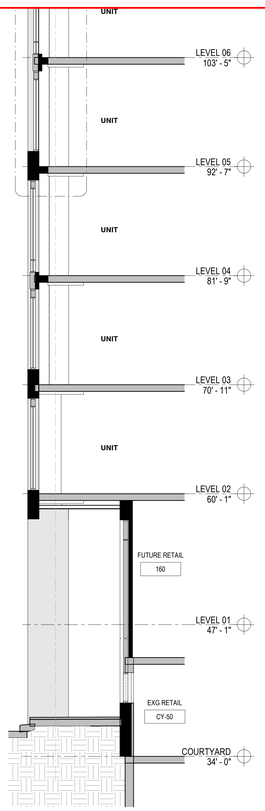

6 SECTION - ALLEY EAST
A311 3/16" = 1'-0"

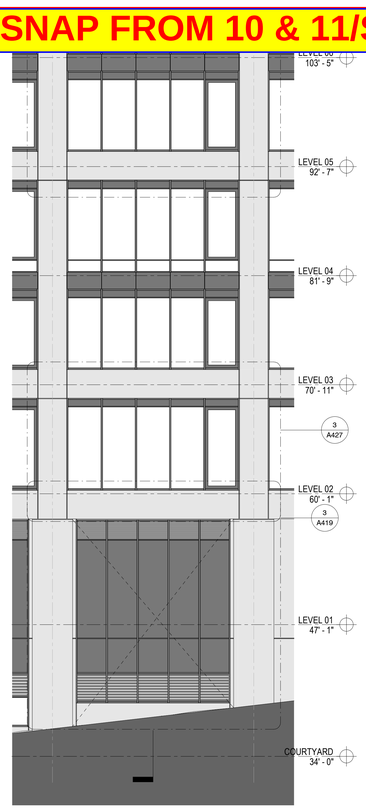

5 ELEVATION - ALEXY EAST
A311 3/16" = 1'-0"

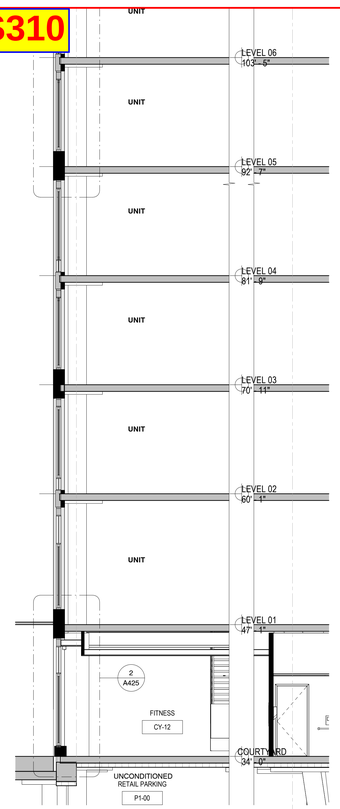

4 SECTION - COURTYARD
A311 3/16" = 1'-0"

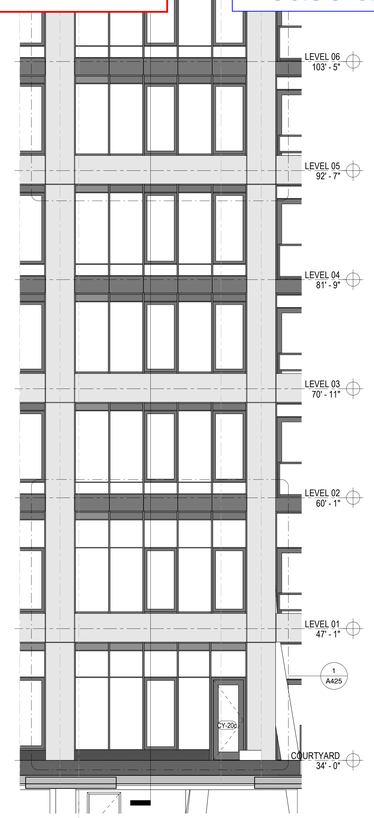

3 ELEVATION - COURTYARD
A311 3/16" = 1'-0"

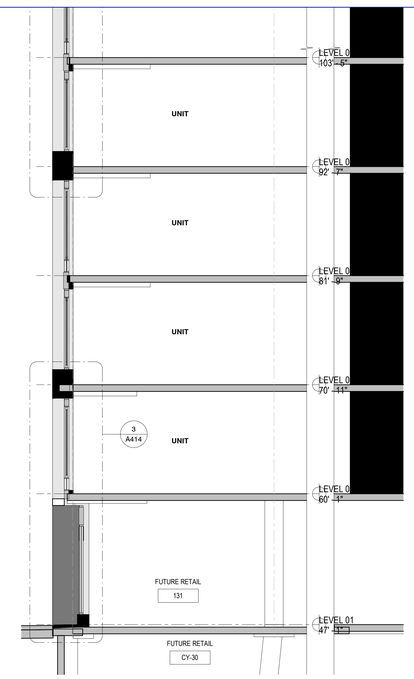

2 SECTION - WEST
A311 3/16" = 1'-0"

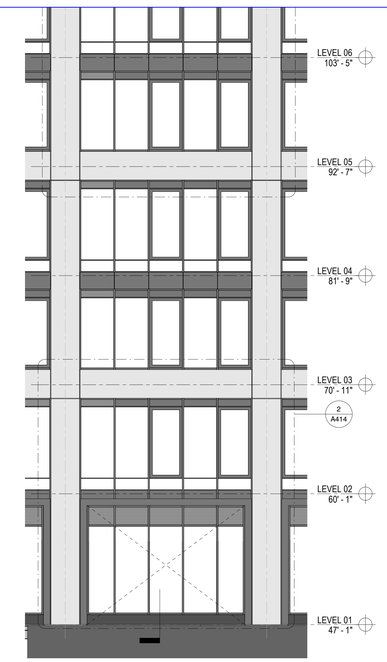

1 ELEVATION - WEST
A311 3/16" = 1'-0"

02 PAGE OF 04

DOB STAMP

1250 Maryland Avenue
1250 MARYLAND AVENUE SW
WASHINGTON, DC 20024

BEYER BLINDER BELLE
3307 M Street Northwest, Suite 301
Washington, DC, 20007
202 333 8000

MECHANICAL & PLUMBING
HURST ENGINEERS
703-534-7872

ELECTRICAL
POWER DESIGN INC.
727-497-9811

STRUCTURAL
RATHGEBER GOSS ASSOCIATES
301-590-0071

CIVIL
GORDON DC
202-869-1600

KEY PLAN

STAMP

NO	DATE	DESCRIPTION

REVISIONS

SUBMITTAL

85% CONSTRUCTION DOCUMENTS

DRAWING TITLE

FACADE ELEVATIONS AND SECTIONS - TYPICAL

SCALE	3/16" = 1'-0"
DATE	3/14/2025
PROJECT NUMBER	6415.00
DRAWING NUMBER	

A311

of

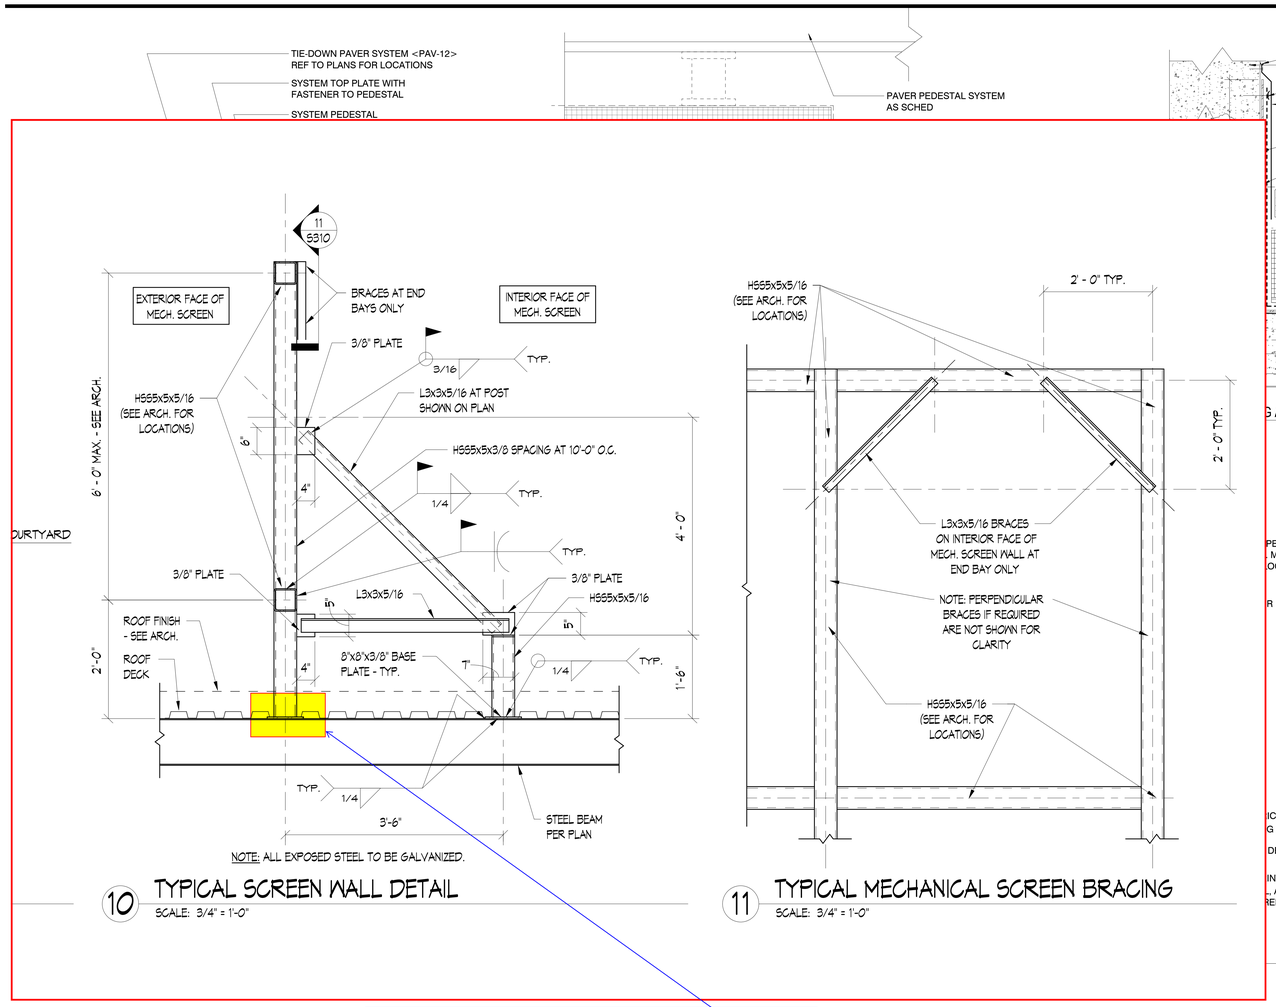

SNAP FROM 10 & 11/S310

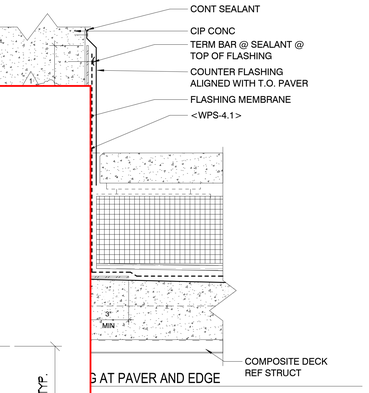

G AT PAVER AND EDGE

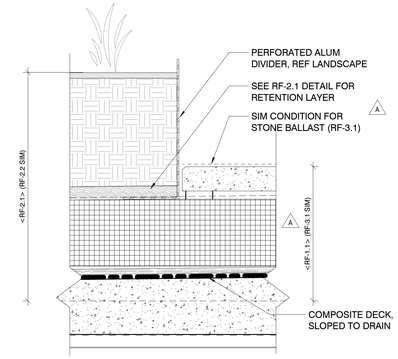

6 A571 ROOF TRANSITION FROM HARDSCAPE TO GREEN ROOF
3" = 1'-0"

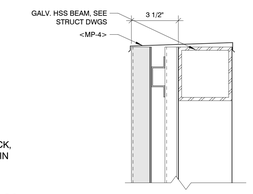

2a A571 PERFORATED SCREEN HEADER DETAIL
3" = 1'-0"

PECIFIED IN
, MARK PAVER
OCATION

R

IC
G COLLAR

DECK, REF

ING
, AS
EF PLUMB

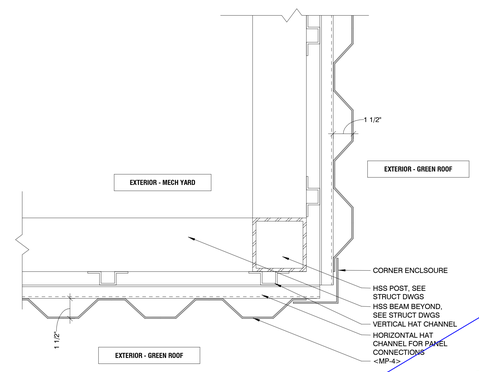

3 A571 PERFERATED SCREEN PLAN DETAIL
3" = 1'-0"

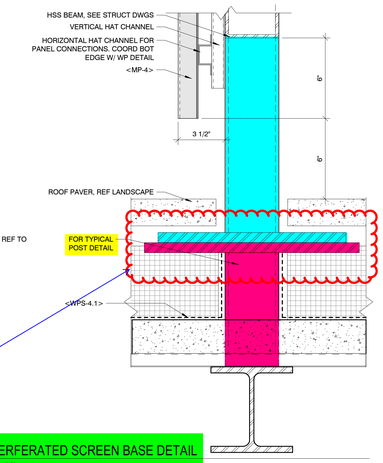

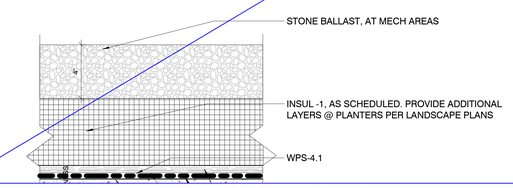

RF-3.1 - STONE BALLAST

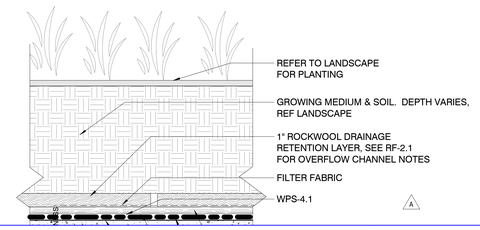

RF-2.2 - INTENSIVE GREEN ROOF
REF LANDSCAPE FOR ADDITIONAL INFO

Q3

Architectural section 2/A571 shows an additional stub post at the screen wall post's bottom connection(highlighted in magenta)but structural section 10/S310 shows a single post directly welded to the roof beam's top flange. Please review and advise.

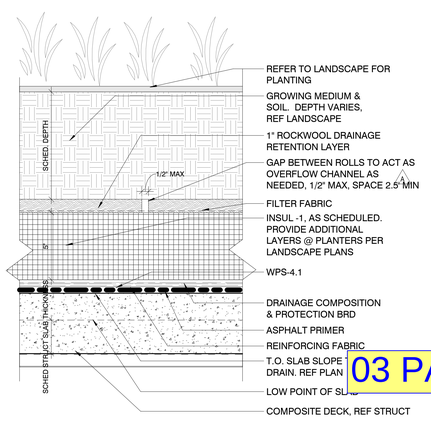

RF-2.1 - INTENSIVE GREEN ROOF
REF LANDSCAPE FOR ADDITIONAL INFO

03 PAGE OF 04

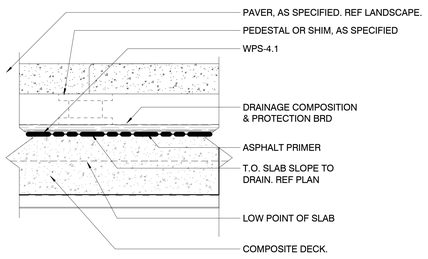

RF-1.3 - TYPICAL POOL PAVERS

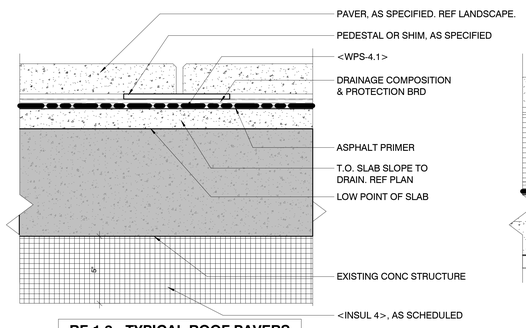

RF-1.2 - TYPICAL ROOF PAVERS
ON EXISTING STRUCTURE

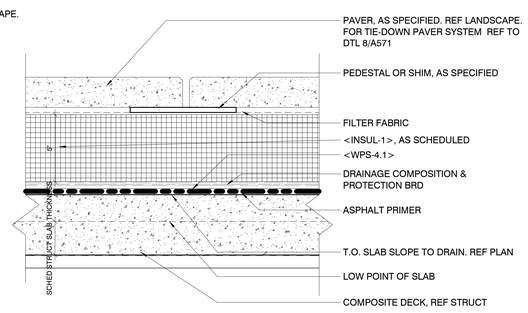

RF-1.1 - TYPICAL ROOF
PAVERS

1 A571 ROOF TYPES
3" = 1'-0"

DOB STAMP

1250 Maryland Avenue
1250 MARYLAND AVENUE SW
WASHINGTON, DC 20024

BEYER BLINDER BELLE
3307 M Street Northwest, Suite 301
Washington, DC, 20007
202 333 8000

MECHANICAL & PLUMBING
HURST ENGINEERS
703-534-7872

ELECTRICAL
POWER DESIGN INC.
727-497-9811

STRUCTURAL
RATHGEBBER GOSS ASSOCIATES
301-590-0071

CIVIL
GORDON DC
202-869-1600

LANDSCAPE
OVS
202-546-7575

INTERIORS
KTGY SDDG
312-274-0707

LIGHTING
CM KLING + ASSOCIATES
703-684-6270

KEY PLAN

STAMP

NO	DATE	DESCRIPTION
1	03/14/25	85% Pricing Changes
A	01/23/25	PERMIT RESPONSE

REVISIONS

SUBMITTAL

85% CONSTRUCTION DOCUMENTS

DRAWING TITLE

ROOF & WATERPROOFING - EXTERIOR DETAILS

SCALE	3" = 1'-0"
DATE	3/14/2025
PROJECT NUMBER	6415.00

DRAWING NUMBER

A571

of

NOTE IF THIS SHEET IS NOT 30"W X 42"D, THEN IT IS NOT THE INTENDED SIZE. IN ALL CASES, WORK TO FIGURED DIMENSIONS.

3/14/2025 2:13:53 PM

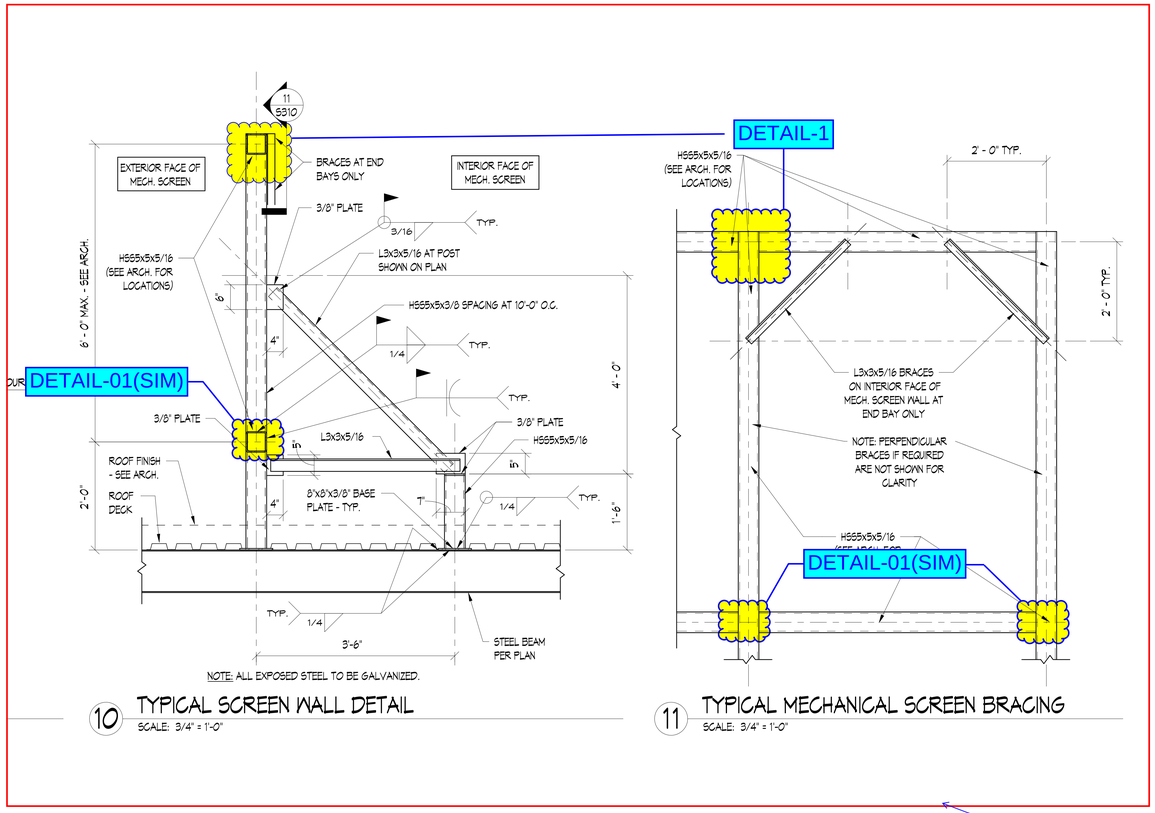

SNAP FROM 10 & 11/S310

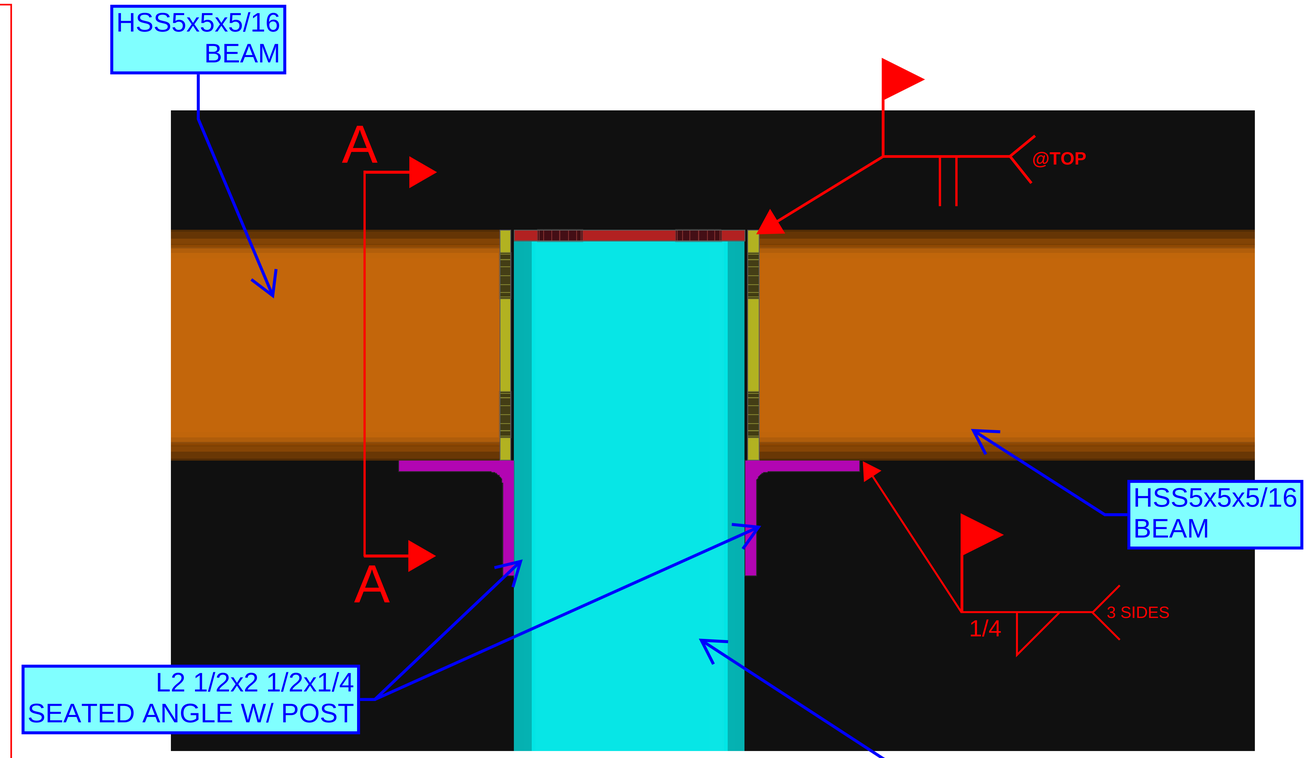

DETAIL-01
SNAP FROM MODEL

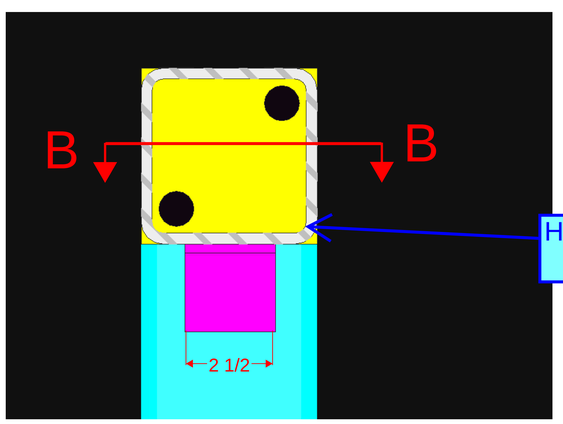

SECTION-A
SNAP FROM MODEL

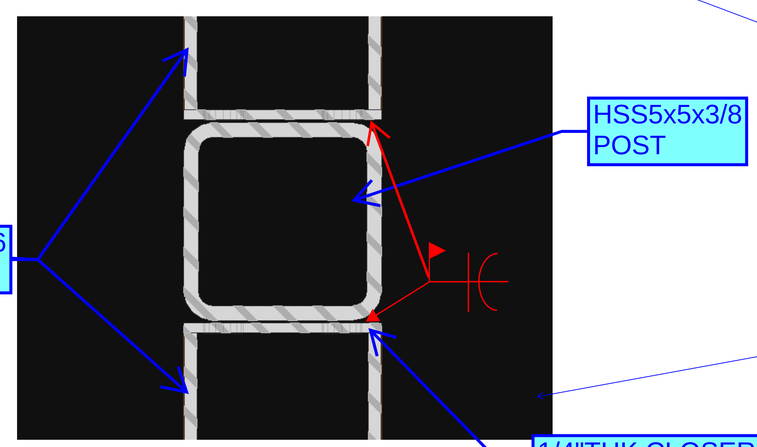

SECTION-B
SNAP FROM MODEL

Q4
PLEASE REVIEW SCREEN WALL HSS BEAM TO HSS POST CONNECTION DETAILS SHOWN DETAIL#1 ARE OK TO PROCEED?