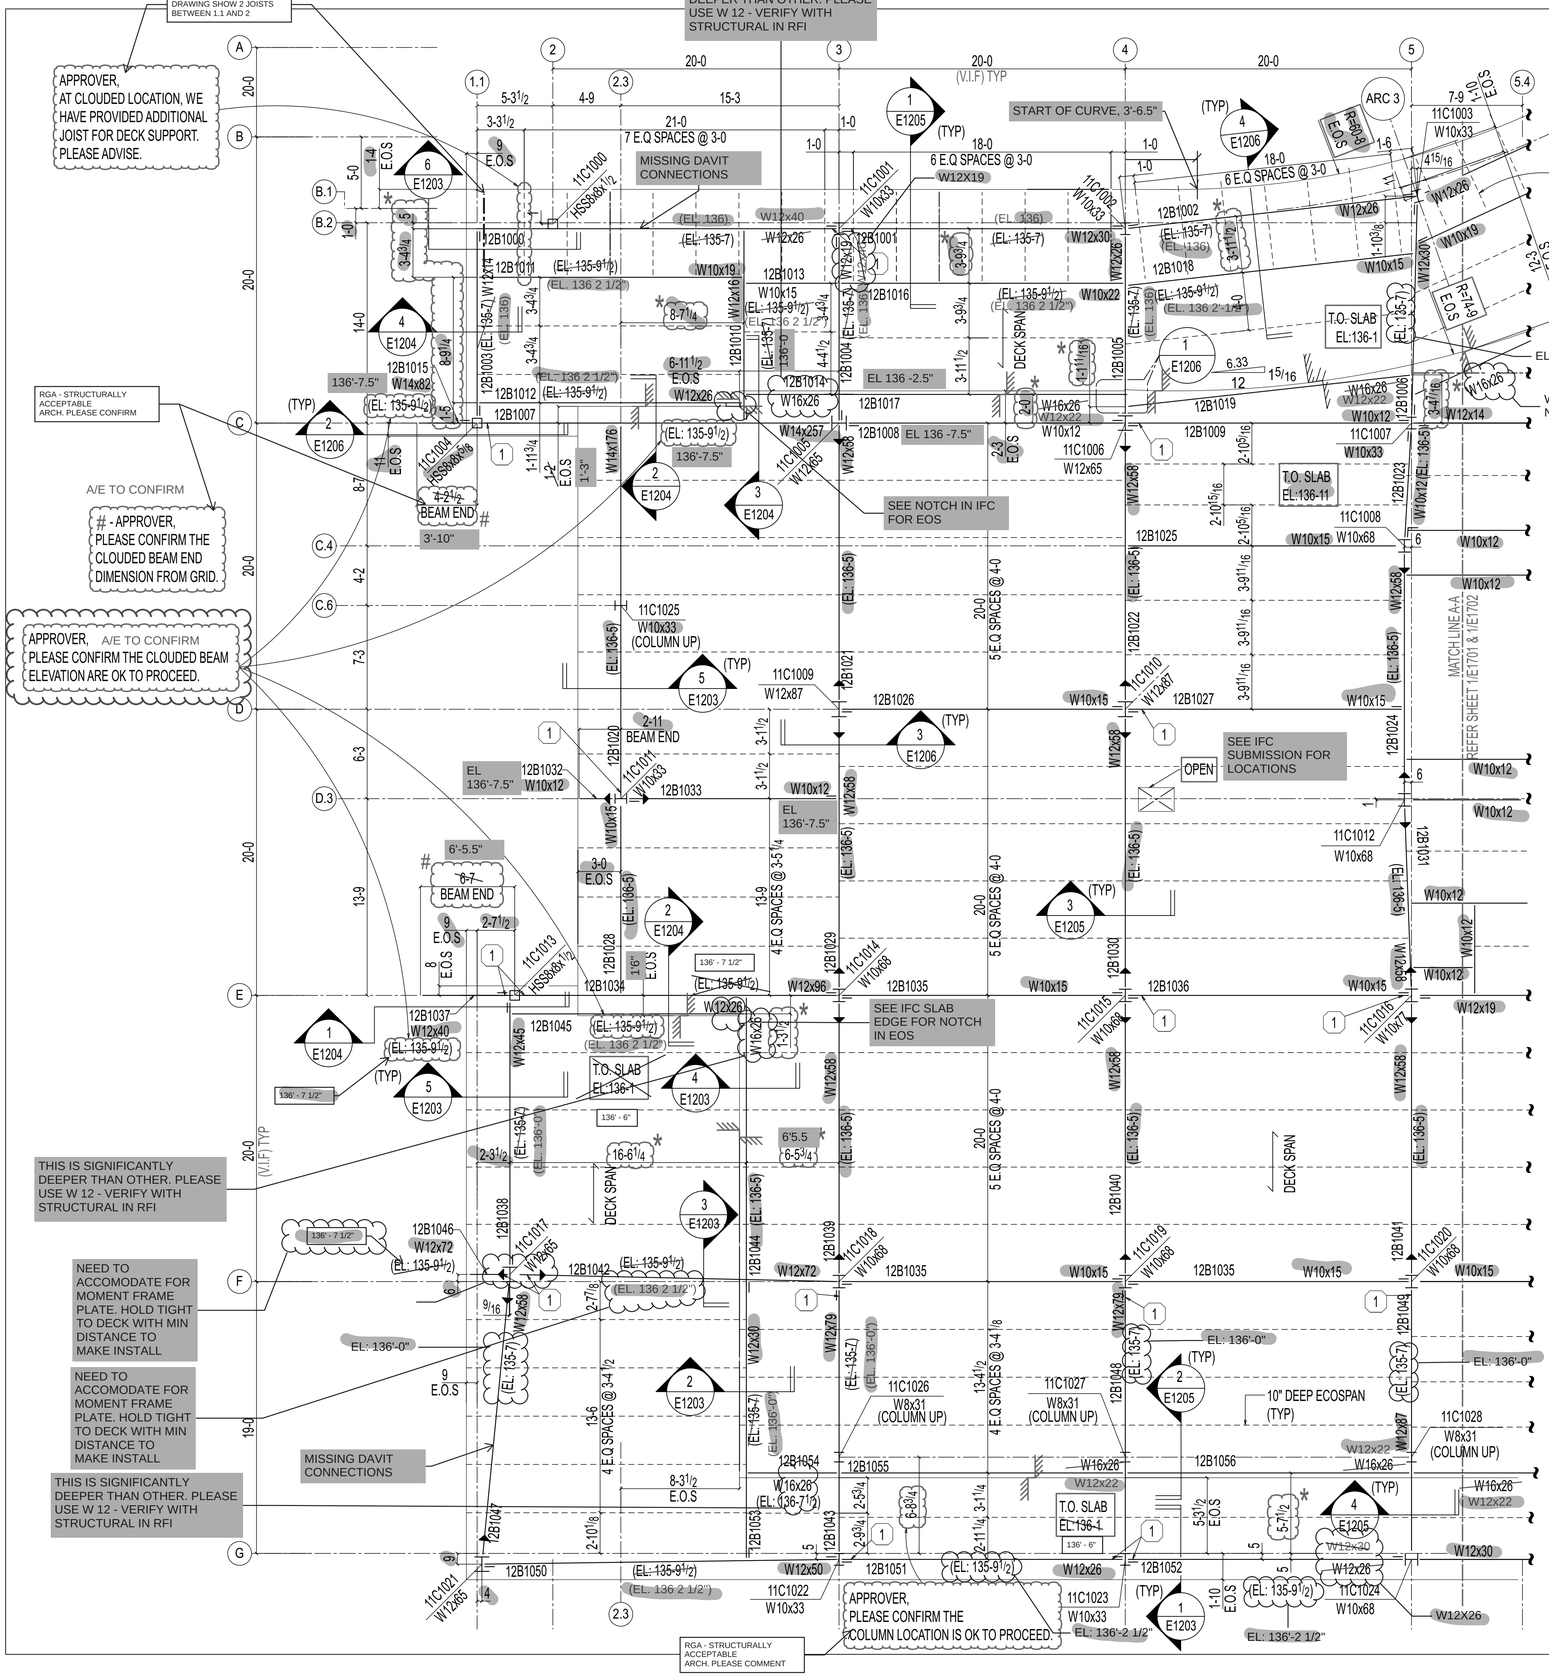

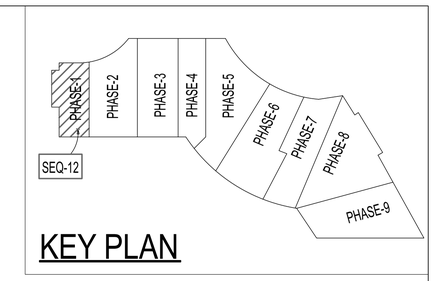

KEY PLAN

RGA - ACCEPTABLE STEEL JOISTS SPACING AT 4'-0" O.C MAX

APPROVER, PLEASE CONFIRM ALL JOIST SPACINGS ARE OK TO PROCEED?

RGA - PLEASE COORD. W/ ARCHITECTURAL SLAB EDGE PLANS FOR BEAM LOCATION

ARCH. PLEASE CONFIRM ALL SLAB EDGE THE DIMENSION

*-APPROVER, PLEASE CONFIRM THE ALL CLOUDED BEAM LOCATIONS ARE OK TO PROCEED?

RGA - ARCH. PLEASE COMMENT

ok asr of BBB

APPROVER, PLEASE CONFIRM, WE HAVE FOLLOWED ALL STEEL IN THE JOB WILL BE 1-COAT STANDARD PPG GRAY SHOP PRIMER.

RGA - SHEAR STUD IS NOT REQUIRED

APPROVER, THE STRUCTURAL PLAN SHOWS SOME BEAM LOCATIONS OFFSET FROM THE COLUMN CENTER. DUE TO FRAMING CONDITIONS AND CONNECTION REQUIREMENTS, WE HAVE ALIGNED THE BEAMS WITH THE COLUMN CENTER. PLEASE CONFIRM.

RGA - CORRECT ALL BEAMS MUST ALIGN WITH COLUMN CENTER

APPROVER, ON STRCTURAL SECTION 3/S306 SHOWS A SHEAR STUD ON THE TOP OF BEAM. HOWEVER, NO DETAILS ARE PROVIDED IN THE GENERAL NOTES AND STRUCTURAL FRAMING PLANS. PLEASE CONFIRM IF THE SHEAR STUD IS REQUIRED. IF REQUIRED PLEASE PROVIDE THE SHEAR STUD DETAILS.

1 E1201 PARTIAL LEVEL-09 FRAMING PLAN (PHASE-1) (SEQ#12)

(REF: 1/S134_A)

PROJECT NORTH & TRUE NORTH

NOTES:
1. TOP OF SLAB EL: 136'-11" (U.N.O).
2. E.O.S - INDICATES EDGE OF SLAB.
3. ▶ - DENOTES MOMENT CONNECTION.
4. ALL FIELD BOLTS SHALL BE 3/4" Ø F1852N TC BOLTS.(U.N.O).
5. ALL GRID DIMENSION TO BE VERIFY IN FIELD.(U.N.O).
6. ⟶ - INDICATES METAL DECK SPAN ORIENTATION DIRECTION.
7. ALL ELEVATION SHOWN FOR TOP OF BEAM (U.N.O).
8. DENOTES SLAB DEVIATION.
9. ALL JOIST TO BE 10" DEEP ECOSPAN COMPOSITE FLOOR JOIST.(U.N.O).
10. TOP OF STEEL EL: 136'-7 1/2".(U.N.O).
11. ALL FIELD BOLTS SHALL BE SNUG TIGHTENED U.N.O
12. (1) - DENOTES 1"Ø F2280N TC BOLT.

RGA - TENSION-CONTROL BOLTS NOT REQUIRED

Q1
We will use non TC bolts for this project per green clouded EOR comment.

REVISIONS

REV#	DWN BY	DESCRIPTION	DATE
A	MNK	ISSUED FOR APPROVAL	Mar 15 2025

LEGEND:
TYP - TYPICAL
V.I.F - VERIFY IN FIELD
E.O.S - EDGE OF SLAB
U.N.O - UNLESS NOTED OTHERWISE
EL. - ELEVATION
T.O. - TOP OF

THE INFORMATION NOTED HEREON THIS DRAWING IS THE PROPERTY OF STEEL FAB ENTERPRISES, INC. AND SHALL NOT BE USED WITHOUT WRITTEN CONSENT.

STEEL FAB ENTERPRISES, LLC
MISCELLANEOUS METALS FABRICATOR AND ERECTORS
623 BAUMGARDNER ROAD, LANCASTER, PA 17603
TEL. (717)464-0330 FAX (717)464-9464
WWW.STEELFABENTERPRISES.COM

AISC CERTIFIED FABRICATOR AND ERECTOR

PROJECT OWNER : HP NAREF, 1250 MARYLAND HOLDINGS 1 LP.
PROJECT DESCRIPTION : 1250 MARYLAND AVENUE
PROJECT ADDRESS : 1250 MARYLAND AVENUE, WASHINGTON, DC 20024
CONTRACTOR : IRON FABRICATION SERVICES, INC.

DRAWN BY : NPH	DATE : 02-27-2025	PROJ. NO. : 25001	REV # A
CHECKED BY : MNK	DATE : 02-27-2025	DWG NO. : E1201	

DWG DESCRIPTION : PARTIAL LEVEL-09 FRAMING PLAN (PHASE-1) (SEQ#12)