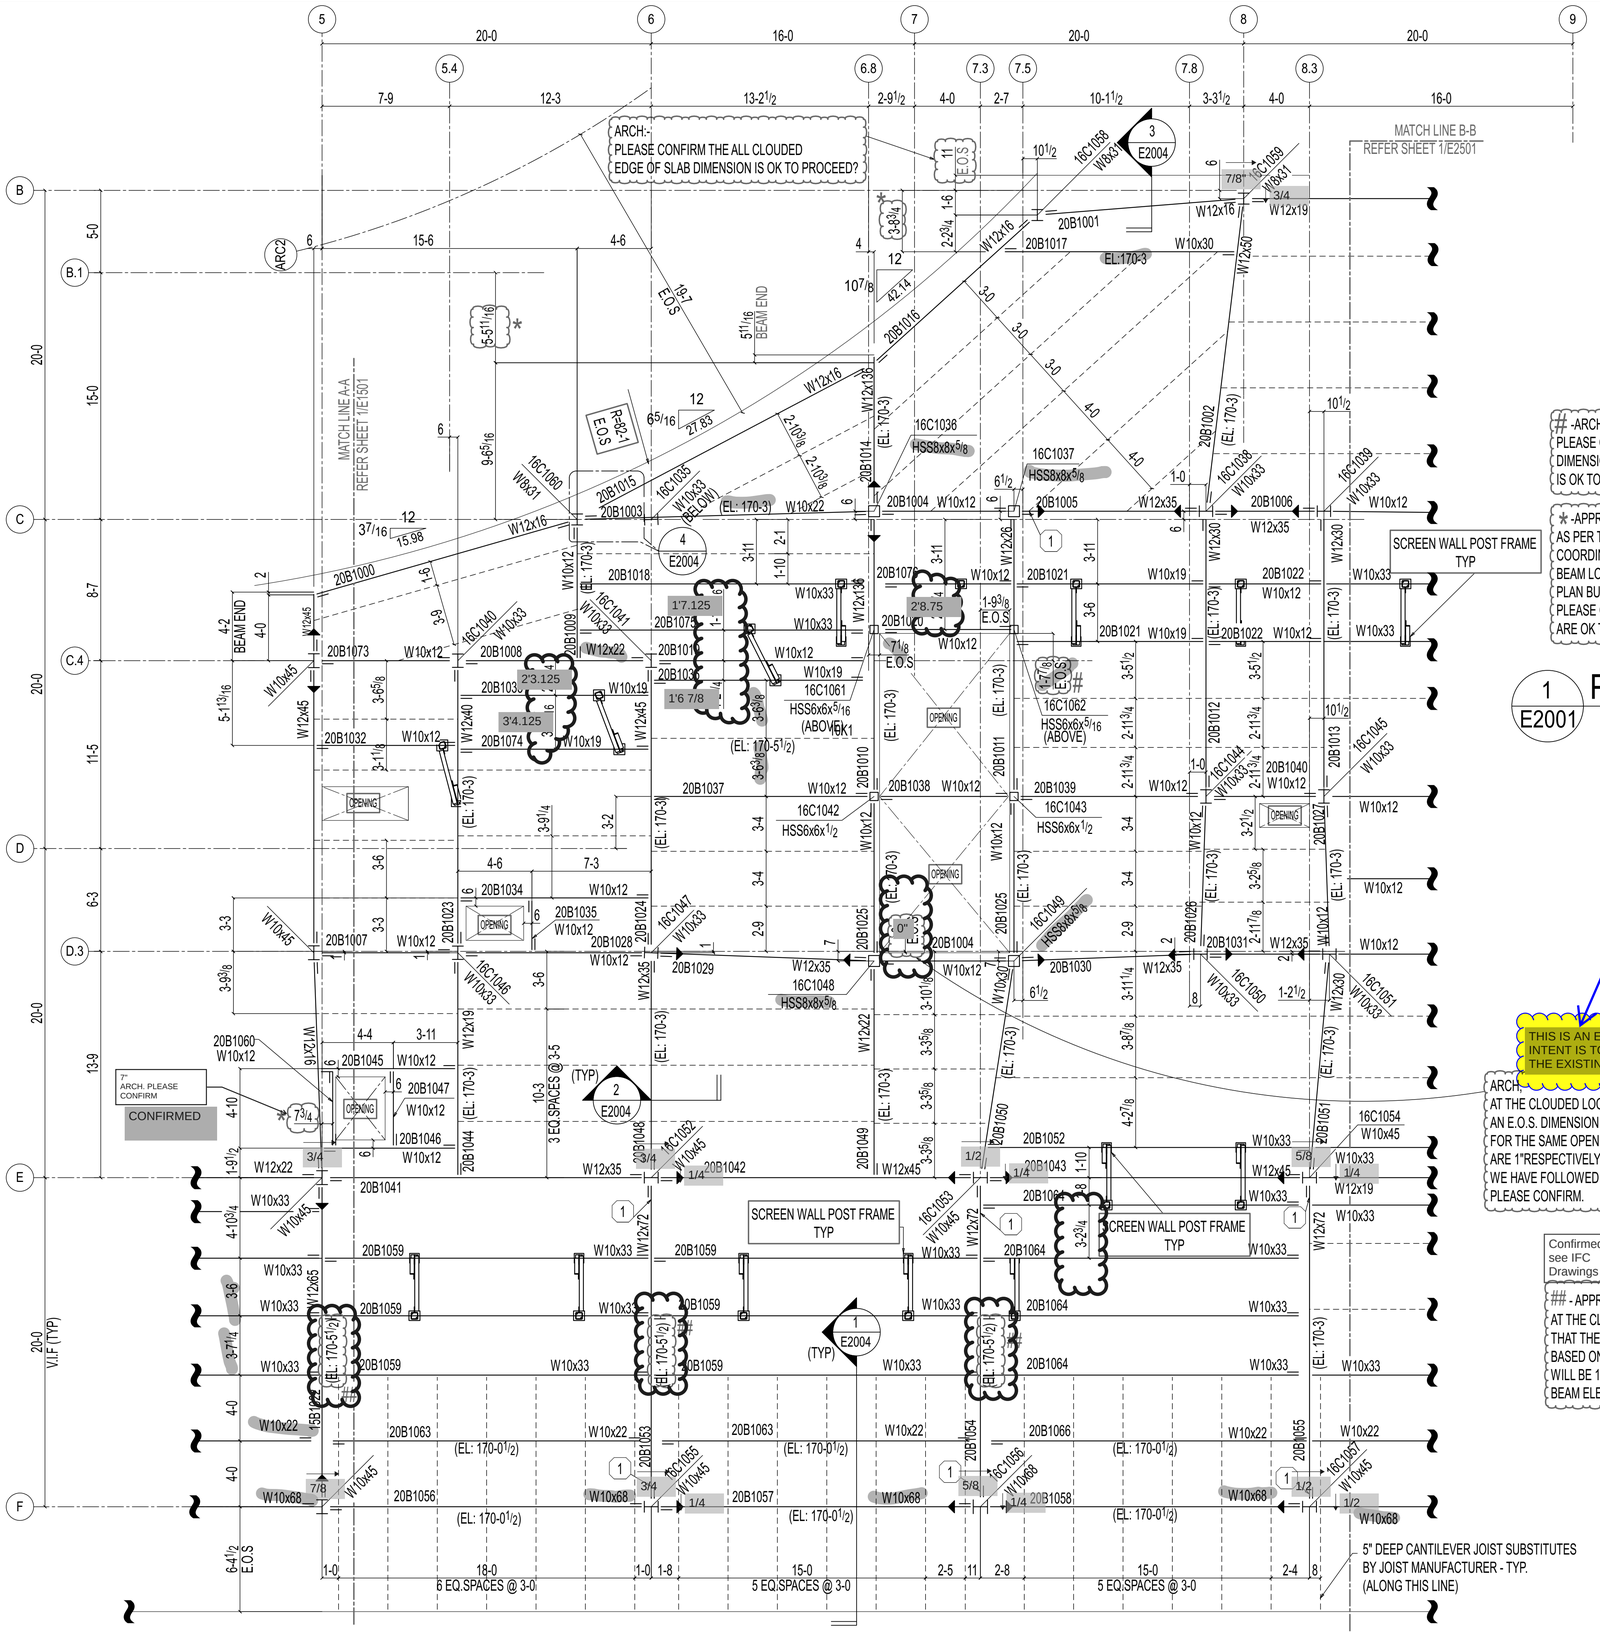

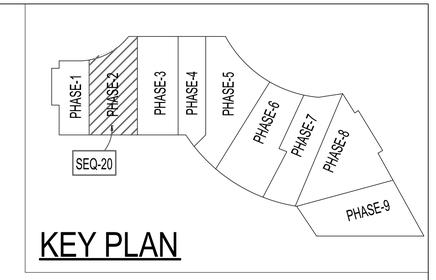

KEY PLAN

-ARCH:-
PLEASE CONFIRM THE CLOUDED EDGE OF SLAB DIMENSION FOR STAIR AND ELEVATOR OPENING IS OK TO PROCEED?

* -APPROVER,
AS PER THE APPROVER'S RETURNS COMMENT STATED THAT COORDINATE WITH ARCHITECTURAL SLAB EDGE PLANS FOR BEAM LOCATION. WE HAVE REVIEWED THE 2/A058 SLAB EDGE PLAN BUT WERE UNABLE TO LOCATE SOME OF THE BEAM LOCATIONS. PLEASE CONFIRM WHETHER ALL CLOUDED BEAM LOCATIONS ARE OK TO PROCEED.

A/E Please Confirm

OK

1 PARTIAL PENTHOUSE ROOF FRAMING PLAN (PHASE-2) (SEQ#20)

1 / E2001

(REF: 1/S137_A)

NOTES:
1.TOP OF SLAB EL: 170-9" (U.N.O).
2.E.O.S - INDICATES EDGE OF SLAB.
3.▶ - DENOTES MOMENT CONNECTION.
4.ALL FIELD BOLTS SHALL BE 3/4" Ø F1852N TC BOLTS.(U.N.O).
5.ALL GRID DIMENSION TO BE VERIFY IN FIELD.(U.N.O).
6.ALL ELEVATION SHOWN FOR TOP OF BEAM (U.N.O).

Q1 Please provide field measurement for existing elevator shaft at this level.

PROJECT NORTH & TRUE NORTH

THIS IS AN EN EXISTING SHAFT OPENING. INTENT IS TO KEEP THE SAME DIMENSIONS AS THE EXISTING. VIF

ARCH,
AT THE CLOUDED LOCATION THE APPROVER COMMENTED AN E.O.S. DIMENSION OF 6" AT LEVEL 9 TO LEVEL11. HOWEVER, FOR THE SAME OPENING AT THE ROOF THE E.O.S. DIMENSIONS ARE 1"RESPECTIVELY. TO MAINTAIN A FLUSH OPENING ALIGNMENT, WE HAVE FOLLOWED THE 6" E.O.S. DIMENSION AT LEVEL 9 TO ROOF. PLEASE CONFIRM.

Confirmed, see IFC Drawings

- APPROVER,
AT THE CLOUDED LOCATION, THE APPROVER COMMENTED THAT THE BEAM ELEVATION SHOULD BE 170'-3". HOWEVER, BASED ON THE FRAMING CONDITIONS, THE BEAM ELEVATION WILL BE 170'-5½". PLEASE RECONFIRM THE CORRECT BEAM ELEVATION.

OK

REVISIONS

REV#	DWN BY	DESCRIPTION	DATE
A	MNK	ISSUED FOR APPROVAL	Mar 15 2025
B	MNK	ISSUED FOR RE-APPROVAL	May 27 2025

THE INFORMATION NOTED HEREON THIS DRAWING IS THE PROPERTY OF STEEL FAB ENTERPRISES, INC. AND SHALL NOTED BE USED WITHOUT WRITTEN CONSENT.

STEEL FAB ENTERPRISES, LLC
MISCELLANEOUS METALS FABRICATOR AND ERECTORS
623 BAUMGARDNER ROAD, LANCASTER, PA 17603
TEL. (717)464-0330 FAX (717)464-9464
WWW.STEELFABENTERPRISES.COM

SK#17
02 pages
2-Queries
Date: 06-27-2025

R : HP NAREF, 1250 MARYLAND HOLDINGS 1 LP.
RIPTION : 1250 MARYLAND AVENUE
ESS : 1250 MARYLAND AVENUE, WASHINGTON, DC 20024
IRON FABRICATION SERVICES, INC.

V	DATE : 02-27-2025	PROJ. NO. : 25001	REV # B
MNK	DATE : 02-27-2025	DWG NO. : E2001	

ON :PARTIAL PENTHOUSE ROOF FRAMING PLAN (PHASE-2) (SEQ#20)

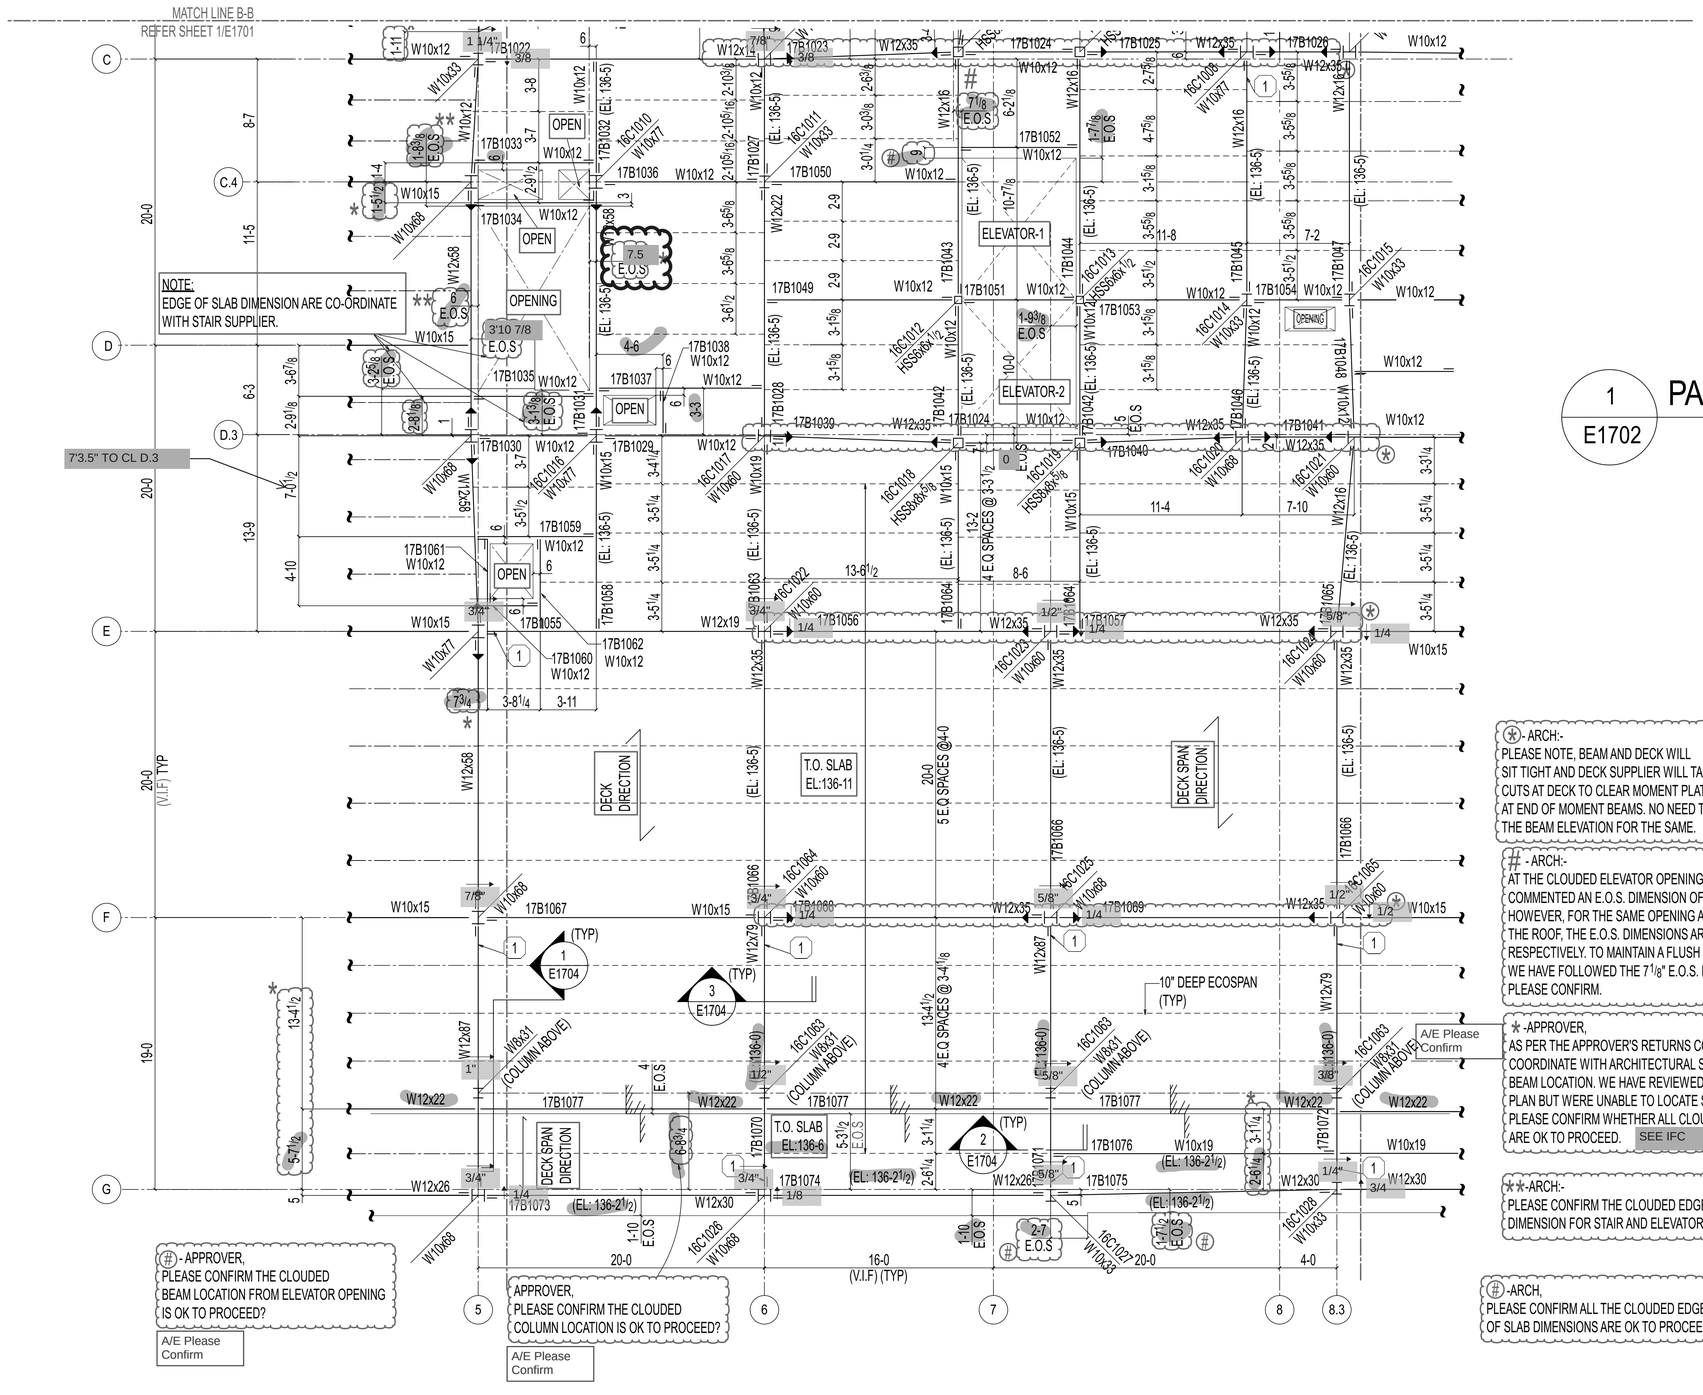

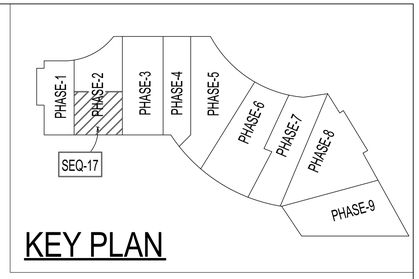

1 / E1702

PARTIAL LEVEL-09 FRAMING PLAN (PHASE-2) (SEQ#17)

(REF: 1/S134_A)

PROJECT NORTH & TRUE NORTH

NOTES:
1.TOP OF SLAB EL: 136'-11" (U.N.O).
2.E.O.S - INDICATES EDGE OF SLAB.
3.▶ - DENOTES MOMENT CONNECTION.
4.ALL FIELD BOLTS SHALL BE ¾" Ø F1852N TC BOLTS.(U.N.O).
5.ALL GRID DIMENSION TO BE VERIFY IN FIELD.(U.N.O).
6.⟷ - INDICATES METAL DECK SPAN ORIENDATION.
7.ALL ELEVATION SHOWN FOR TOP OF BEAM (U.N.O).
8. DENOTES SLAB DEVIATION.
9.ALL JOIST TO BE 10" DEEP ECOSPAN COMPOSITE FLOOR JOIST.(U.N.O).
10.TOP OF STEEL EL: 136'-7½".(U.N.O).
11. ALL FIELD BOLTS SHALL BE SNUG TIGHTENED U.N.O
12. (1) -DENOTES 1"Ø F2280N TC BOLT

Q2
Please provide Field measurement for the existing elevator shaft opening.

(*) - ARCH:-
PLEASE NOTE, BEAM AND DECK WILL SIT TIGHT AND DECK SUPPLIER WILL TAKE CUTS AT DECK TO CLEAR MOMENT PLATES AT END OF MOMENT BEAMS. NO NEED TO DOWN THE BEAM ELEVATION FOR THE SAME.

(#) - ARCH:-
AT THE CLOUDED ELEVATOR OPENING, THE APPROVER COMMENTED AN E.O.S. DIMENSION OF 3 1/8" AT LEVEL 9. HOWEVER, FOR THE SAME OPENING AT LEVEL 11 AND THE ROOF, THE E.O.S. DIMENSIONS ARE 7 1/8" AND 7", RESPECTIVELY. TO MAINTAIN A FLUSH OPENING ALIGNMENT, WE HAVE FOLLOWED THE 7 1/8" E.O.S. DIMENSION AT LEVEL 9 TO ROOF. PLEASE CONFIRM.

INTENT IS TO MATCH EXISTING ELEVATOR SHAFT OPENING BELOW> VIF

(*) -APPROVER,
AS PER THE APPROVER'S RETURNS COMMENT STATED THAT COORDINATE WITH ARCHITECTURAL SLAB EDGE PLANS FOR BEAM LOCATION. WE HAVE REVIEWED THE 1/A057 SLAB EDGE PLAN BUT WERE UNABLE TO LOCATE SOME OF THE BEAM LOCATIONS. PLEASE CONFIRM WHETHER ALL CLOUDED BEAM LOCATIONS ARE OK TO PROCEED.

(**) -ARCH:-
PLEASE CONFIRM THE CLOUDED EDGE OF SLAB DIMENSION FOR STAIR AND ELEVATOR OPENING ARE OK TO PROCEED?

(#) - APPROVER,
PLEASE CONFIRM THE CLOUDED BEAM LOCATION FROM ELEVATOR OPENING IS OK TO PROCEED?

APPROVER,
PLEASE CONFIRM THE CLOUDED COLUMN LOCATION IS OK TO PROCEED?

(#) -ARCH,
PLEASE CONFIRM ALL THE CLOUDED EDGE OF SLAB DIMENSIONS ARE OK TO PROCEED?

REVISIONS

REV#	DWN BY	DESCRIPTION	DATE
A	MNK	ISSUED FOR APPROVAL	Mar 15 2025
B	MNK	ISSUED FOR RE-APPROVAL	May 27 2025

THE INFORMATION NOTED HEREON THIS DRAWING IS THE PROPERTY OF STEEL FAB ENTERPRISES, INC. AND SHALL NOTED BE USED WITHOUT WRITTEN CONSENT.

STEEL FAB ENTERPRISES, LLC
MISCELLANEOUS METALS FABRICATOR AND ERECTORS
623 BAUMGARDNER ROAD, LANCASTER, PA 17603
TEL. (717)464-0330 FAX (717)464-9464
WWW.STEELFABENTERPRISES.COM
AISC CERTIFIED FABRICATOR AND ERECTOR

PROJECT OWNER : HP NAREF, 1250 MARYLAND HOLDINGS 1 LP.
PROJECT DESCRIPTION : 1250 MARYLAND AVENUE
PROJECT ADDRESS : 1250 MARYLAND AVENUE, WASHINGTON, DC 20024
CONTRACTOR : IRON FABRICATION SERVICES, INC.

DRAWN BY : JSV	DATE : 02-27-2025	PROJ. NO. : 25001	REV # B
CHECKED BY : MNK	DATE : 02-27-2025	DWG NO. : E1702	

DWG DESCRIPTION : PARTIAL LEVEL-09 FRAMING PLAN (PHASE-2) (SEQ#17)