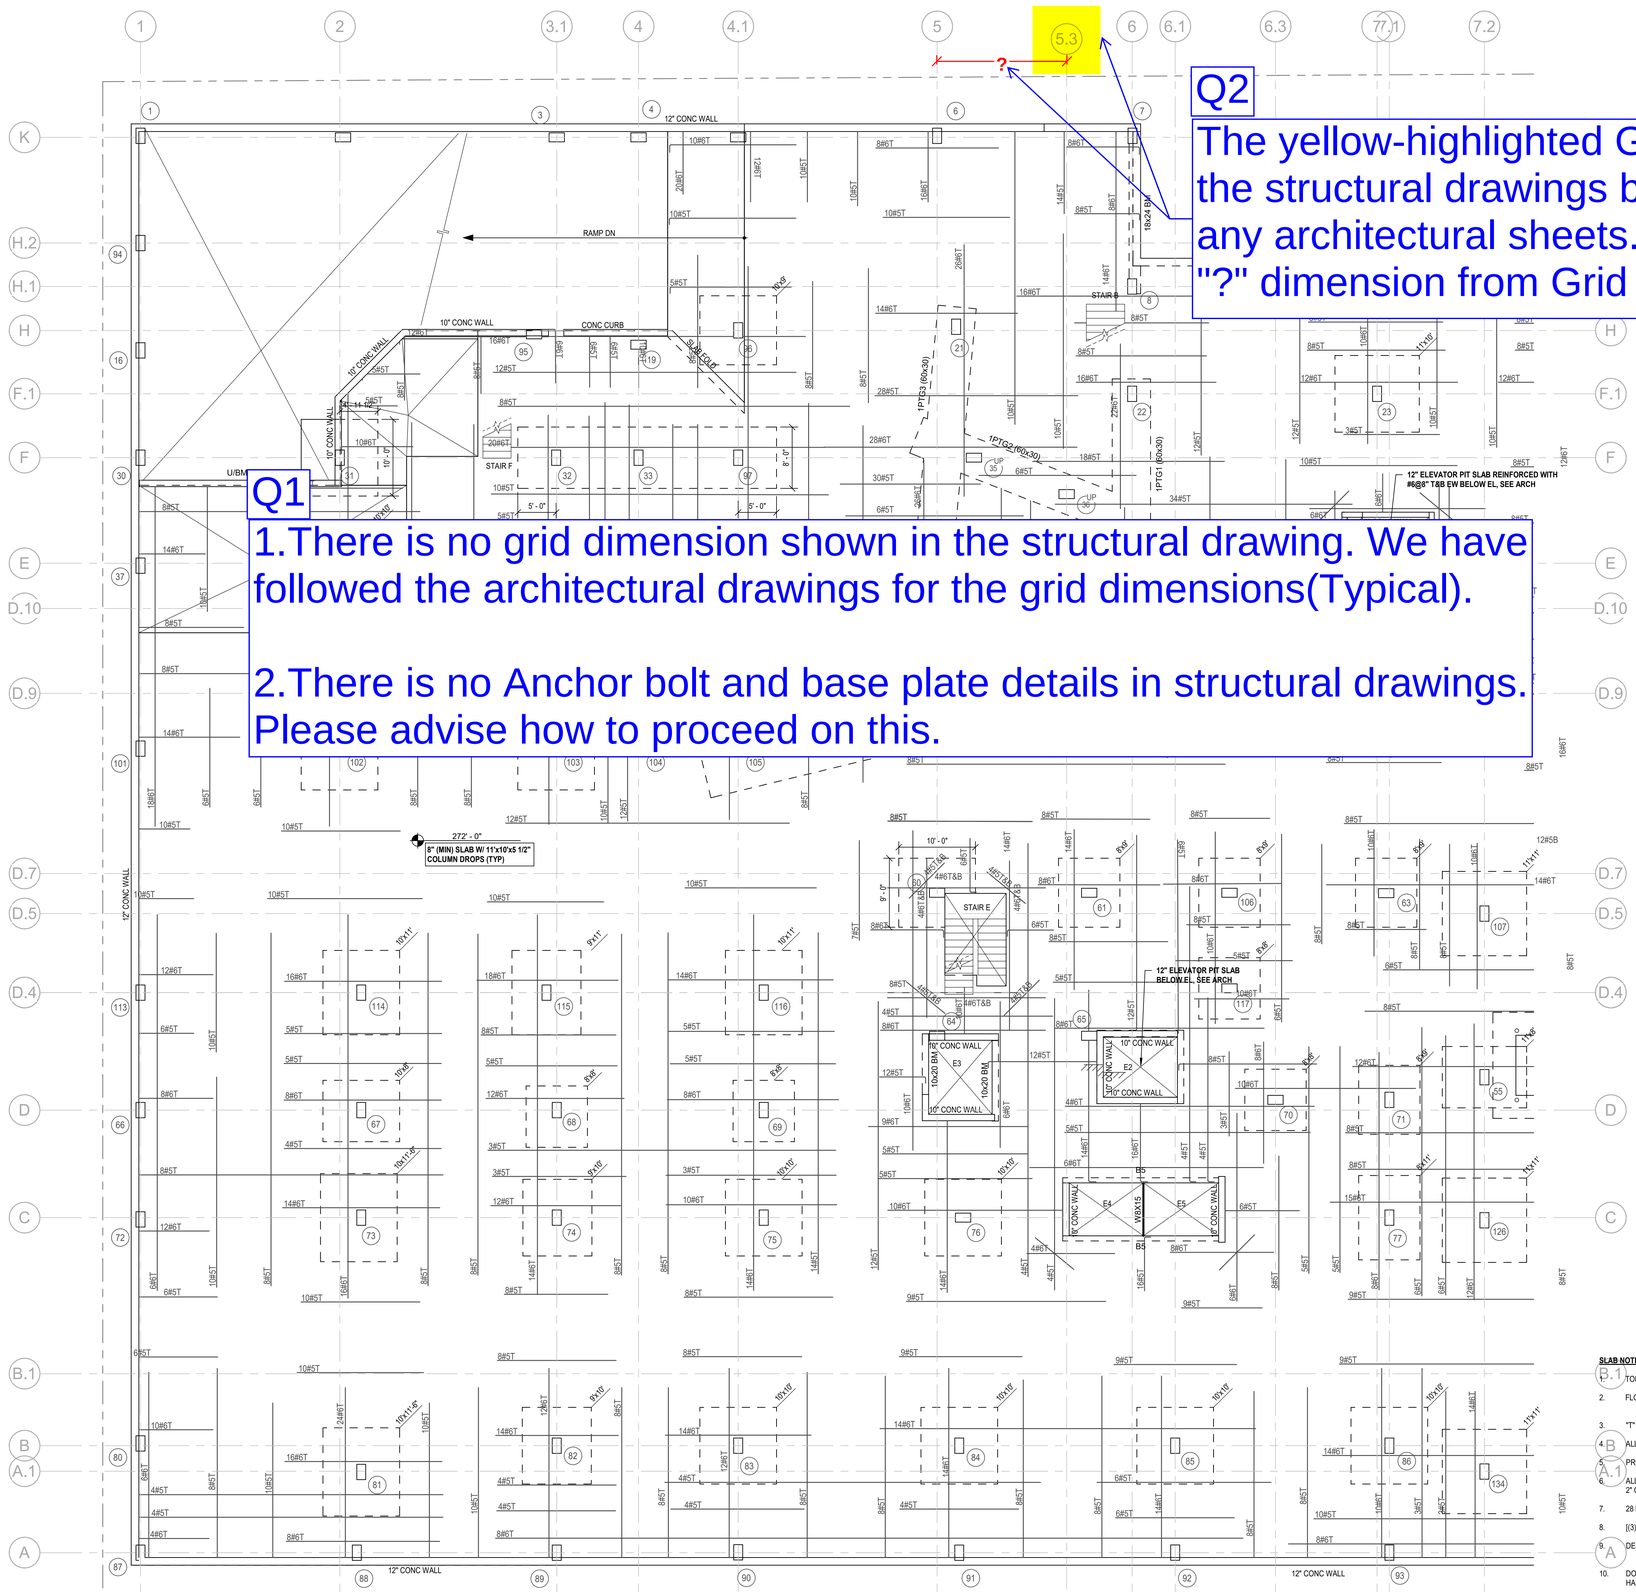

Q2

The yellow-highlighted Grid 5.3 is shown in the structural drawings but not shown on any architectural sheets. Please provide the "?" dimension from Grid “5. to grid 5.3”

Q1

1.There is no grid dimension shown in the structural drawing. We have followed the architectural drawings for the grid dimensions(Typical).

2.There is no Anchor bolt and base plate details in structural drawings. Please advise how to proceed on this.

1 GARAGE LEVEL 1 PLAN - PART A
1/8" = 1'-0"

SLAB NOTES

1. TOP OF SLAB ELEVATION SEE PLAN & ARCH DWGS.
2. FLOOR SLAB TO BE 8" (MIN) CONCRETE SLAB REINF W/ #4@12" BOT EACH WAY (GENERAL REINF) & 10" (MIN) CONCRETE SLAB REINF W/ #5@12" BOT EACH WAY (GENERAL REINF).
3. "T" DENOTES TOP BARS; "B" DENOTES BOTTOM BARS.
4. ALL REINF SHOWN ON PLAN SHALL BE IN ADDITION TO GENERAL REINF (U.N.O.)
5. PROVIDE 3/4" CONCRETE COVER FOR TOP & BOTTOM BARS IN SLAB (U.N.O.)
6. ALL REINF STEEL (TOP & BOTTOM) IN THE GARAGE TO BE EPOXY COATED AND SHALL HAVE 2" CONCRETE COVER FOR TOP BARS (U.N.O.)
7. 28 DAY CONCRETE STRENGTH OF SLAB, f'c= 5000 psi (NWC). TYPICAL (U.N.O.)
8. [(3)8SR] DENOTES SHEAR HEAD REINFORCING EACH WAY SEE TYPICAL DETAILS.
9. DESIGN LIVE LOAD = 40 psf AT GARAGE
   = 100 psf AT AMENITY, STAIRS AND MECHANICAL AREAS
10. DO NOT REMOVE SHORING BELOW THE HANGING FLOOR SLAB WHICH ARE SUPPORTED BY THE HANGERS UNTIL THE FLOOR SLAB ABOVE ACH
11. DENOTES SLOPING COLUMN, SEE CO

OUTERMOST LAYER

SK#01
ONE page
ONE-Query
Date: 01-09-2026

FILLAT+ ARCHITECTURE
400 E. PRATT | SUITE 502 | BALTIMORE MD | 21202
Ph: 410.576.9310 | PFARC.COM

STRUCTURAL ENGINEER
TADJER-COHEN-EDELSON ASSOCIATES ,INC.
1109 SILVER SPRING ST., SUITE 510
SILVER SPRING, MD 20910
(301) 587-1820
12402000

MEP ENGINEER
ALLEN & SHARIFF ENGINEERING, LLC
7061 DEEPAGE DRIVE
COLUMBIA, MD 21045
(443) 545-7100

CIVIL ENGINEER
BOHLER
901 DULANEY VALLEY ROAD, SUITE 801
TOWSON, MD 21204
(410) 821-7900

INTERIOR DESIGNER
LOONEY & ASSOCIATES
20 N WACKER DR. SUITE 2010
CHICAGO, ILLINOIS 60606
(312) 329-0464

LANDSCAPE
EDSA
400 E. PRATT STREET, SUITE 502
BALTIMORE, MARYLAND 21202
(443)539-3350

TEHNOLOGY
MICHAEL RAISER ASSOCIATES, INC.
500 VALLEY ROAD SUITE 106
WAYNE, NJ 07470
(973)305-0011

FREDERICK CONFERENCE CENTER HOTEL

20 SOUTH CARROLL STREET
FREDERICK, MARYLAND, 21701

Copyright 2021 Fillat Architecture, Inc. All rights reserved

IFC SET

GARAGE LEVEL 1 PLAN - PART I

PROJECT NO.:	13013
SCALE:	1/8" = 1'-0"
DATE:	12.19.2025

REVISIONS:

1	PRE-GMP	06.09.25
2	IFC SET	12.19.25

S102A

12/19/2025 12:56:50 PM