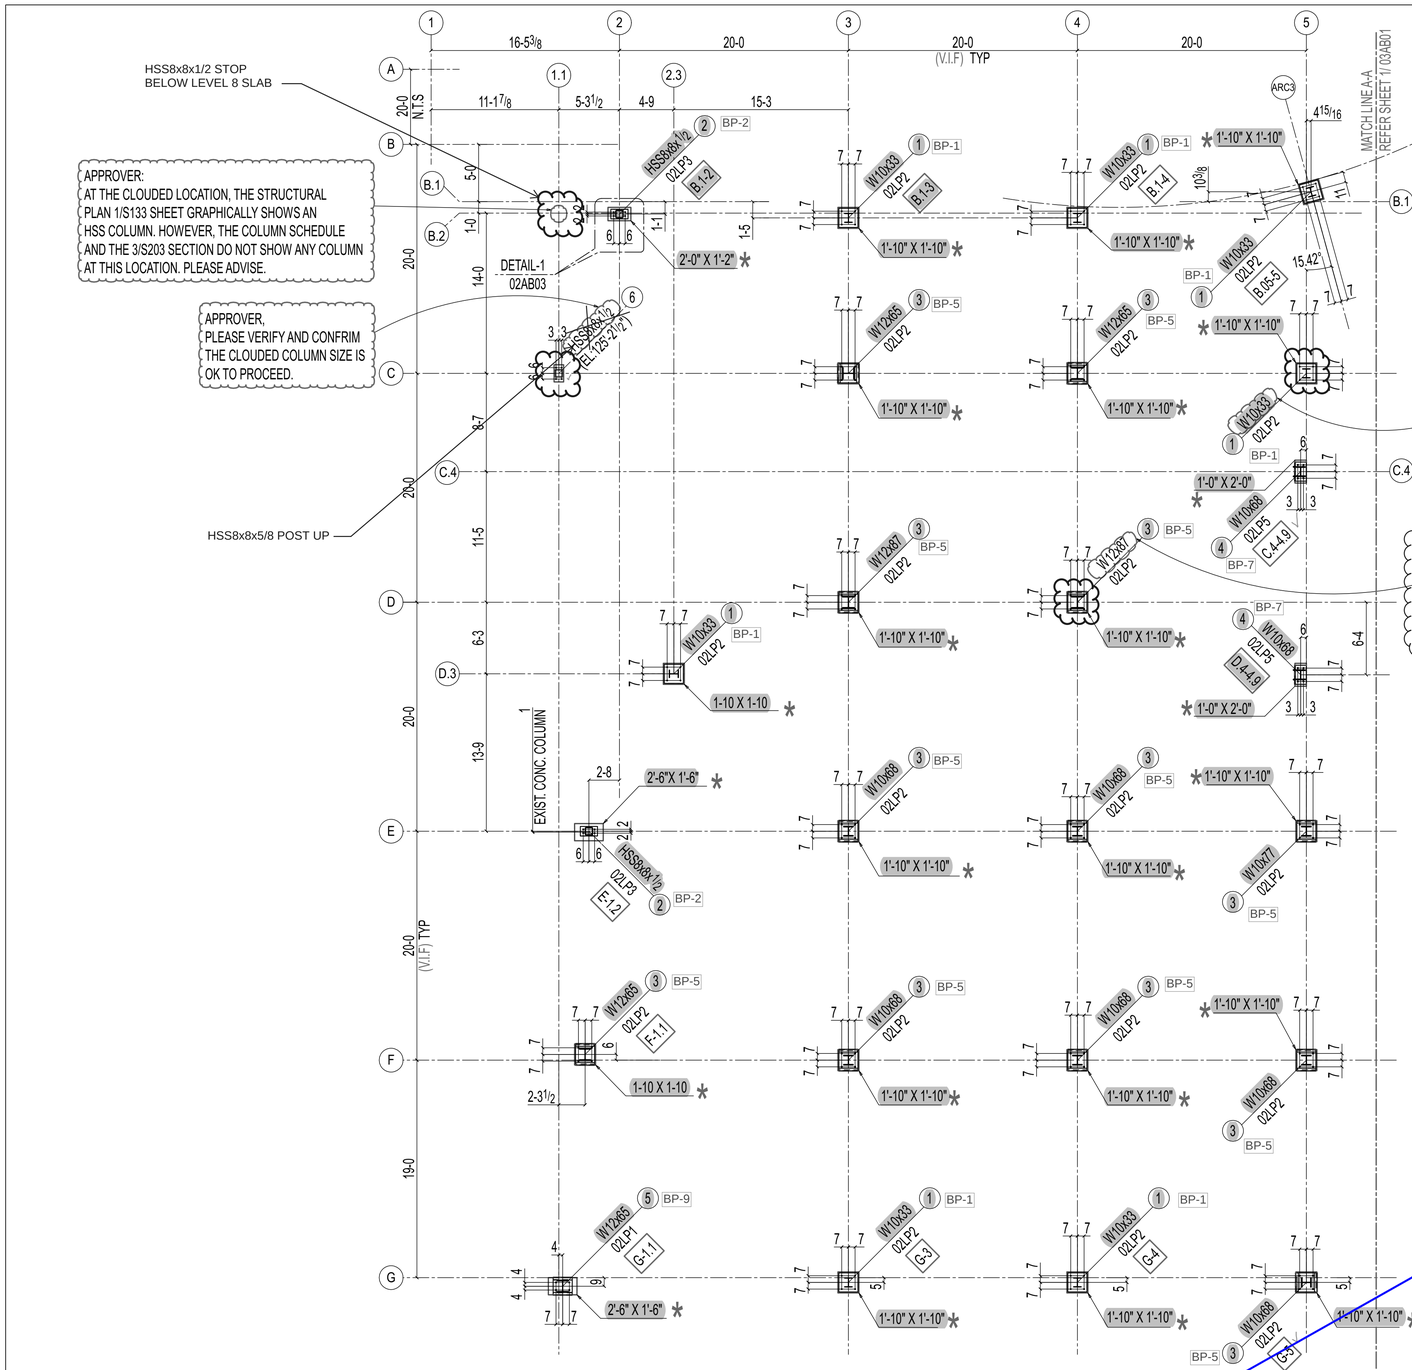

PARTIAL LEVEL-08 NEW STEEL COLUMN ADHESIVE ANCHOR PLAN-(PHASE-1) (SEQ#-1)

1 / 02AB01

(REF: 1/S133_A)

NOTES:
1. TOP OF EXSITING SLAB ELEVATION AT LEVEL-08: [125'1"](V.I.F)
2. ALL COLUMN BOTTOM OF BASE PL. ELEVATION [128-2 1/4"] (U.N.O).
3. ALL GRID DIMENSIONS TO BE VERIFY IN FIELD (U.N.O).
4. REFER SHEET 02AB02 & 02AB03 FOR ADHESIVE ANCHOR SETTING TYPES OF PHASE-01.
5. ALL NEW STEEL COLUMN LOCATIONS ARE CENTER OF EXISTING CONCRETE COLUMN (U.N.O).
6. ALL DIMENSIONS ARE LOCATE FROM GRID TO CENTER OF NEW & EXIST. CONCRETE COLUMN CENTER (U.N.O).
7. ALL ELEVATION SHOWN IN PLAN FOR BOTTOM OF BASE PLATE (U.N.O).

APPROVER, PLEASE VERIFY AND CONFIRM CLOUDED EXISTING LEVEL-08 SLAB ELEVATION.

SLAB ELEVATION IS AN EXISTING CONDITION THAT SHOULD BE VERIFIED IN FIELD.

PROJECT NORTH & TRUE NORTH

PLEASE CENTER ALL NEW STEEL COLUMN WITH CENTER OF EXISTING CONCRETE COLUMN.

FOR LOCATIONS WHERE CENTERINING IS NOT POSSIBLE, PROVIDE DETAIL LOCATION INFORMATION FOR REVIEW

ALL COLUMNS TO BE CENTERED ON EXG COLUMNS UNLESS NOTED OTHERWISE.

RESPONSIBILITY OF CONTRACTOR AND GC TO VERIFY ALL EXISTING CONDITIONS, REVIEWED TO CONFIRM WITH DESIGN DRAWINGS ONLY

EXISTING COLUMN SIZES CONFIRMED WITH EXISTING STRUCTURAL DRAWINGS. VERIFY IN FIELD FOR ACTUAL COLUMN SIZE

SEE NOTE 8 ON S133 "ALL GRID DIMENSIONS TO BE VERIFIED IN FIELD"

ARCH. PLEASE COMMENTS

APPROVER, PLEASE REVIEW AND VERIFY ALL EXISTING COLUMN SIZES ARE OK TO PROCEED?

APPROVER; STRUCTURAL DRWAINGS DO NOT SHOW PREVIOUS GRID DIMENSIONS FOR THE ARC WHICH WE HAVE FOLLOWED. HOWEVER WE HAVE RECEIVED FIELD MEASUREMENT FOR THE CENTER OF EXISTING COLUMN.

AFTER INCORPORTAING THE ALL FIELD MEASUREMENT, WE HAVE PLACE MOST OF THE NEW COLUMNS AT CENTER OF EXISTING CONCRETE COLUMNS.

ADDITIONALLY,WE HAVE OFFSETTED THE SOME COLUMN FROM CENTER OF EXISTING CONCRETE COLUMN SINCE STRUCTURAL DRAWING GRAPHICALLY SHOWNS THE NEW COLUMN FROM EX.CONCRETE COLUMN CENTER PLEASE ADVISE TYPICAL FOR THIS PROJECT.

Q1

Please field verify and confirm the clouded top of existing slab elevation at 8th level.

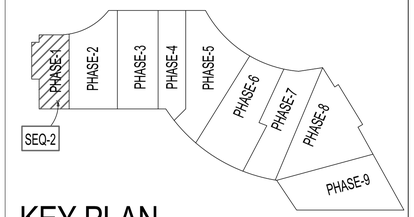

KEY PLAN

JB- Reviewed for Compliance

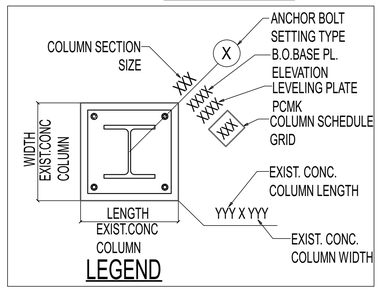

LEGEND

REVISIONS

REV#	DWN BY	DESCRIPTION	DATE
A	MNK	ISSUED FOR APPROVAL	Mar 1 2025

THE INFORMATION NOTED HEREON THIS DRAWING IS THE PROPERTY OF STEEL FAB ENTERPRISES, INC. AND SHALL NOTED BE USED WITHOUT WRITTEN CONSENT.

STEEL FAB ENTERPRISES, LLC
AISC CERTIFIED FABRICATOR AND ERECTOR
MISCELLANEOUS METALS FABRICATOR AND ERECTORS
623 BAUMGARDNER ROAD, LANCASTER, PA 17603
TEL. (717)464-0330 FAX (717)464-9464
WWW.STEELFABENTERPRISES.COM

PROJECT OWNER : 1250 MARYLAND AVENUE
PROJECT DESCRIPTION : 1250 MARYLAND AVENUE
PROJECT ADDRESS : 12
CONTRACTOR : BALFO
DRAWN BY : JSV
CHECKED BY : MNK
DWG DESCRIPTION : PA ANCHOR PLAN (PHASE-1)(SEQ#-2)

SK#05
06 pages
Date: 05-07-2025

NOTE IF THIS SHEET IS NOT 36"W X 48"L THEN IT IS NOT THE INTENDED SIZE. IN ALL CASES WORK TO FIGURED DIMENSIONS.

COLUMN SIZE	FLANGE PLATES WIDTH	FLANGE PLATES THICKNESS	FLANGE PLATES LENGTH	# OF BOLTS
W14X455 TO 730	16"	3/4"	1'-6 1/2"	12
257 TO 426	14"	5/8"	1'-6 1/2"	12
145 TO 233	14"	1/2"	1'-6 1/2"	12
90 TO 132	14"	3/8"	1'-0 1/2"	8
43 TO 82	8"	3/8"	1'-0 1/2"	8
W12X120 TO 336	8"	5/8"	1'-0 1/2"	8
40 TO 106	8"	3/8"	1'-0 1/2"	8
W10X33 TO 112	8"	3/8"	1'-0 1/2"	8
W8X31 TO 67	8"	3/8"	1'-0 1/2"	8
24 & 28	6"	3/8"	1'-0 1/2"	8

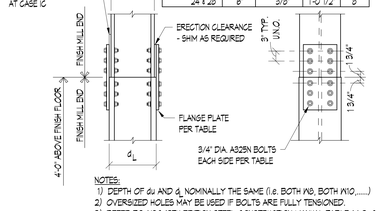

NOTES:
1) DEPTH OF d_U AND d_L NOMINALLY THE SAME (i.e. BOTH W8, BOTH W10,.....)
2) OVERSIZED HOLES MAY BE USED IF BOLTS ARE FULLY TENSIONED.
3) REFER TO AISC 13th EDITION STEEL CONSTRUCTION MANUAL TABLE 14-3, CASE I.

1 COLUMN SPLICE-BOLTED (FOR GRAVITY COLUMNS)
SCALE: 3/4" = 1'-0"

COLUMN SIZE	FLANGE PLATES WIDTH	FLANGE PLATES THICKNESS	FLANGE PLATES LENGTH	NUMBER OF BOLTS BELOW SPLICE
W14X455 TO 730	16"	3/4"	1'-6 1/2"	8
257 TO 426	14"	5/8"	1'-6 1/2"	8
145 TO 233	14"	1/2"	1'-6 1/2"	4
90 TO 132	14"	3/8"	1'-0 1/2"	4
43 TO 82	8"	3/8"	1'-0 1/2"	4
W12X120 TO 336	8"	5/8"	1'-0 1/2"	4
40 TO 106	8"	3/8"	1'-0 1/2"	4
W10X33 TO 112	8"	3/8"	1'-0 1/2"	4
W8X31 TO 67	8"	5/8"	1'-0 1/2"	4
24 & 28	6"	3/8"	1'-0 1/2"	4

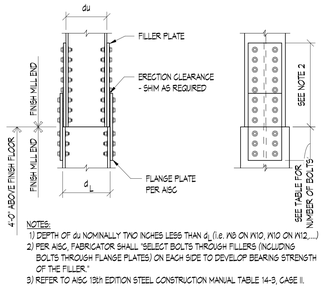

NOTES:
1) DEPTH OF d_U NOMINALLY TWO INCHES LESS THAN d_L (i.e. W8 ON W10, W10 ON W12,...)
2) PER AISC, FABRICATOR SHALL "SELECT BOLTS THROUGH FILLERS (INCLUDING BOLTS THROUGH FLANGE PLATES) ON EACH SIDE TO DEVELOP BEARING STRENGTH OF THE FILLER."
3) REFER TO AISC 13th EDITION STEEL CONSTRUCTION MANUAL TABLE 14-3, CASE II.

2 COLUMN SPLICE - BOLTED (FOR GRAVITY COLUMNS)
SCALE: 3/4" = 1'-0"

Q2

Please field verify and confirm that the ALL existing concrete columns (in this project)height is 3-0 from top of existing slab at level-8.

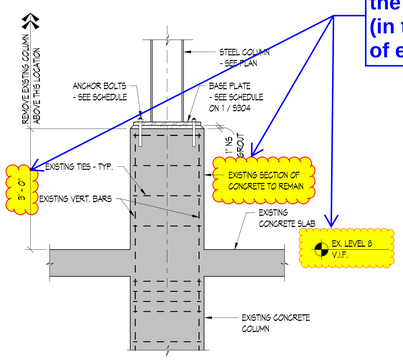

3 COLUMN BASE DETAIL - EXISTING PIER
SCALE: 3/4" = 1'-0"

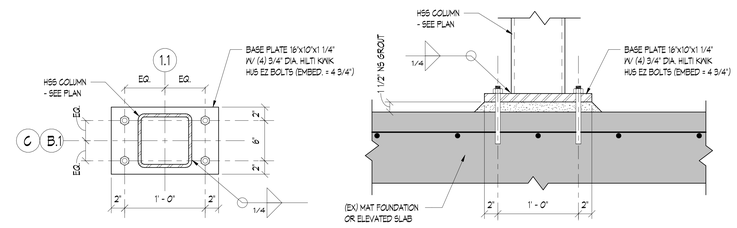

NOTE:
CONTRACTOR TO LOCATE EXISTING REBAR PRIOR TO PLATE FABRICATION DO NOT DRILL THROUGH REBAR.

4 DETAIL
SCALE: 1 1/2" = 1'-0"

STEEL COLUMN SCHEDULE

LEVEL \ COLUMN MARK	A-7	A-8	A-9	A-10	A-10.9	A-11.1	A-12	A-13	A-14	A-15	A.2-13	A.2-8	A.2-9	A.2-10	A.2-10.9	A.2-11.1	A.2-12	A.2-13	A.8-5.9	B-7	B-8	B-9	B-10	B-10.9	B-11.1	B-12	B-13	B-14	B-15	B.05-5	B.1-2	B.1-3	B.1-4	B.1-7.4	B.1-8	B.1-9	B.1-10	B.1-10.9	B.1-11.1	B.1-12	B.1-13	B.1-14	B.2-8	B.2-9	B.2-10
STAIR ROOF	
ROOF	
LEVEL 11																																		W8x31	W8x31	W8x31	W8x31	W8x31	W8x31	W8x31	W8x31	W8x31			
LEVEL 10											W8x31									W10x33								W10x33	W10x33					TRANSFER	TRANSFER	TRANSFER	TRANSFER	TRANSFER	TRANSFER	TRANSFER	TRANSFER	TRANSFER			
LEVEL 9											W8x31	W8x31	W8x31	W8x31	W8x31	W8x31	W8x31	W8x31																									W8x31	W8x31	W8x31
	W10x33	W10x77	W10x77	W10x60	W10x77	W10x77	W10x77	W10x77	W10x77	W10x33	TRANSFER	TRANSFER	TRANSFER	TRANSFER	TRANSFER	TRANSFER	TRANSFER	TRANSFER	W10x33	W10x33	W10x68	W10x68	W12x106	W10x60	W12x65	W10x68	W10x68	W10x68	W10x33	W10x33	HSS6x6x1/2	W10x33	W10x33										TRANSFER	TRANSFER	TRANSFER
LEVEL 8	
BASE PLATE (1/S301)	BP-1	BP-5	BP-5	BP-5	BP-5	BP-7	BP-5	BP-5	BP-5	BP-1									BP-1	BP-1	BP-5	BP-5	BP-13	BP-7	BP-8	BP-5	BP-5	BP-4	BP-1	BP-1	BP-2	BP-1	BP-1												
AXIAL LOAD (KIPS)	60	95	95	75	40	50	90	95	65	75	30	75	75	75	40	40	75	55	65	140	175	175	145	100	90	170	175	230	165	65	60	60	60	15	50	55	55	25	30	55	55	50	100	105	70
SHEAR LOAD (KIPS)	
MOMENT (KIPS-FT)	

STEEL COLUMN SCHEDULE

LEVEL \ COLUMN MARK	B.2-10.9	B.2-11.1	B.2-12	B.2-13	B.4-6.8	B.4-7.4	B.4-7.8	B.4-8.4	B.4-9	C-3	C-4	C-5	C-5.8	C-6	C-10	C-10.9	C-11.1	C-12	C-13	C-14	C.4-3.8	C.4-4	C.4-4.9	C.4-5.4	C.4-6	C.6-2.3	C.6-9	C.8-6.8	C.8-7.4	C.8-7.8	C.8-8.4	D-3	D-3.1	D-4	D-10	D-10.9	D-11.1	D-12	D-13	D-14	D-15	D.3-2.3	D.4-4.9	D.4-5.4	D.4-6
STAIR ROOF	
ROOF	
LEVEL 11													W8x31								W8x31	W8x31											W8x31													
LEVEL 10					HSS6x6x1/2	HSS6x6x1/2	W10x33	W10x33	W10x45	W10x54	W10x33	W10x33	TRANSFER	W10x33	W10x54	W10x45	W10x60	W10x45	W10x45	W10x45	TRANSFER	TRANSFER	W10x45	W10x33	W10x33		W10x45	HSS6x6x1/2	HSS6x6x1/2	W10x33	W10x33	W10x68		TRANSFER	W10x68	W10x45	W10x45	W10x45	W10x45	W10x45	W10x77	W10x68		W10x45	W10x33	W10x33
LEVEL 9	W8x31	W8x31	W8x31	W8x31																						W10x33																				
	TRANSFER	TRANSFER	TRANSFER	TRANSFER	HSS6x6x1/2	HSS6x6x1/2	W10x77	W10x68	W10x60	W12x65	W12x65			W10x60	W10x68	W10x65	W10x96	W10x60	W10x60	W10x60			W10x68	W10x77	W10x33	TRANSFER	W10x60	HSS6x6x1/2	HSS6x6x1/2	W10x33	W10x33	W12x87		W10x77	W10x60	W10x60	W12x79	W12x72	W12x72	W12x87	W12x96	W10x33	W10x68	W10x77	W10x60
LEVEL 8	
BASE PLATE (1/S301)	BP-11	BP-11	BP-12	BP-13	BP-6	BP-6	BP-7	BP-7	BP-9	BP-5	BP-5	BP-1		BP-4	BP-5	BP-7	BP-7	BP-4	BP-5	BP-4			BP-7	BP-7	BP-2		BP-9	BP-3	BP-3	BP-2	BP-2	BP-5		BP-5	BP-9	BP-7	BP-7	BP-5	BP-5	BP-5	BP-14	BP-1	BP-7	BP-7	BP-11
AXIAL LOAD (KIPS)	95	55	105	105	170	80	155	115	185	190	150	125	25	210	235	125	140	265	275	230	20	30	105	95	175	105	160	85	85	85	85	165	95	225	290	140	150	205	290	230	105	180	125	110	150
SHEAR LOAD (KIPS)					5	5	5	5	5					5	10	5	10	10	10	10			10				5					10		10	5	10	10	5	5	10	10		10		5
MOMENT (KIPS-FT)					20	20	20	5	5					15	45	25	25	30	40	30			25				25					25		30	25	30	30	20	20	45	35		25		15

COLUMN SCHEDULE NOTES:
1) AXIAL LOAD, SHEAR LOAD, AND MOMENT ARE FACTORED VALUES.
2) LATERAL COLUMN SPLICE CONNECTION ARE DESIGNED BY STEEL MANUFACTURER'S ENGINEERS. SHEAR LOAD AND MOMENT ARE GIVEN AT THE SPLICE LOCATION.

5 STEEL COLUMN SCHEDULE
SCALE: 3/4" = 1'-0"

DOB STAMP

1250 Maryland Avenue
1250 MARYLAND AVENUE SW
WASHINGTON, DC 20024

BEYER BLINDER BELLE
3307 M Street Northwest, Suite 301
Washington, DC, 20007
202 333 8000

MECHANICAL & PLUMBING
HURST ENGINEERS
703-534-7872

ELECTRICAL
POWER DESIGN INC.
727-497-9811

STRUCTURAL
RATHGEBER GOSS ASSOCIATES
301-590-0071

CIVIL
GORDON DC
202-869-1600

LANDSCAPE
OVS
202-546-7575

INTERIORS
KTGY SDDG
312-274-0707

LIGHTING
CM KLING + ASSOCIATES
703-684-6270

KEY PLAN

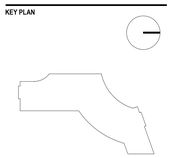

STAMP

NO	DATE	DESCRIPTION
	02/06/2025	SSW001

REVISIONS

SUBMITTAL
85% CONSTRUCTION DOCUMENTS

DRAWING TITLE
STEEL COLUMNS SCHEDULE AND TYPICAL DETAILS

SCALE	As indicated
DATE	01/24/25
PROJECT NUMBER	6415.00
DRAWING NUMBER	**S301**

of

Autodesk Docs://6415 - 1250 Maryland Avenue/S-6415-1250 Maryland Ave-R24.rvt

3/13/2025 5:32:8 PM

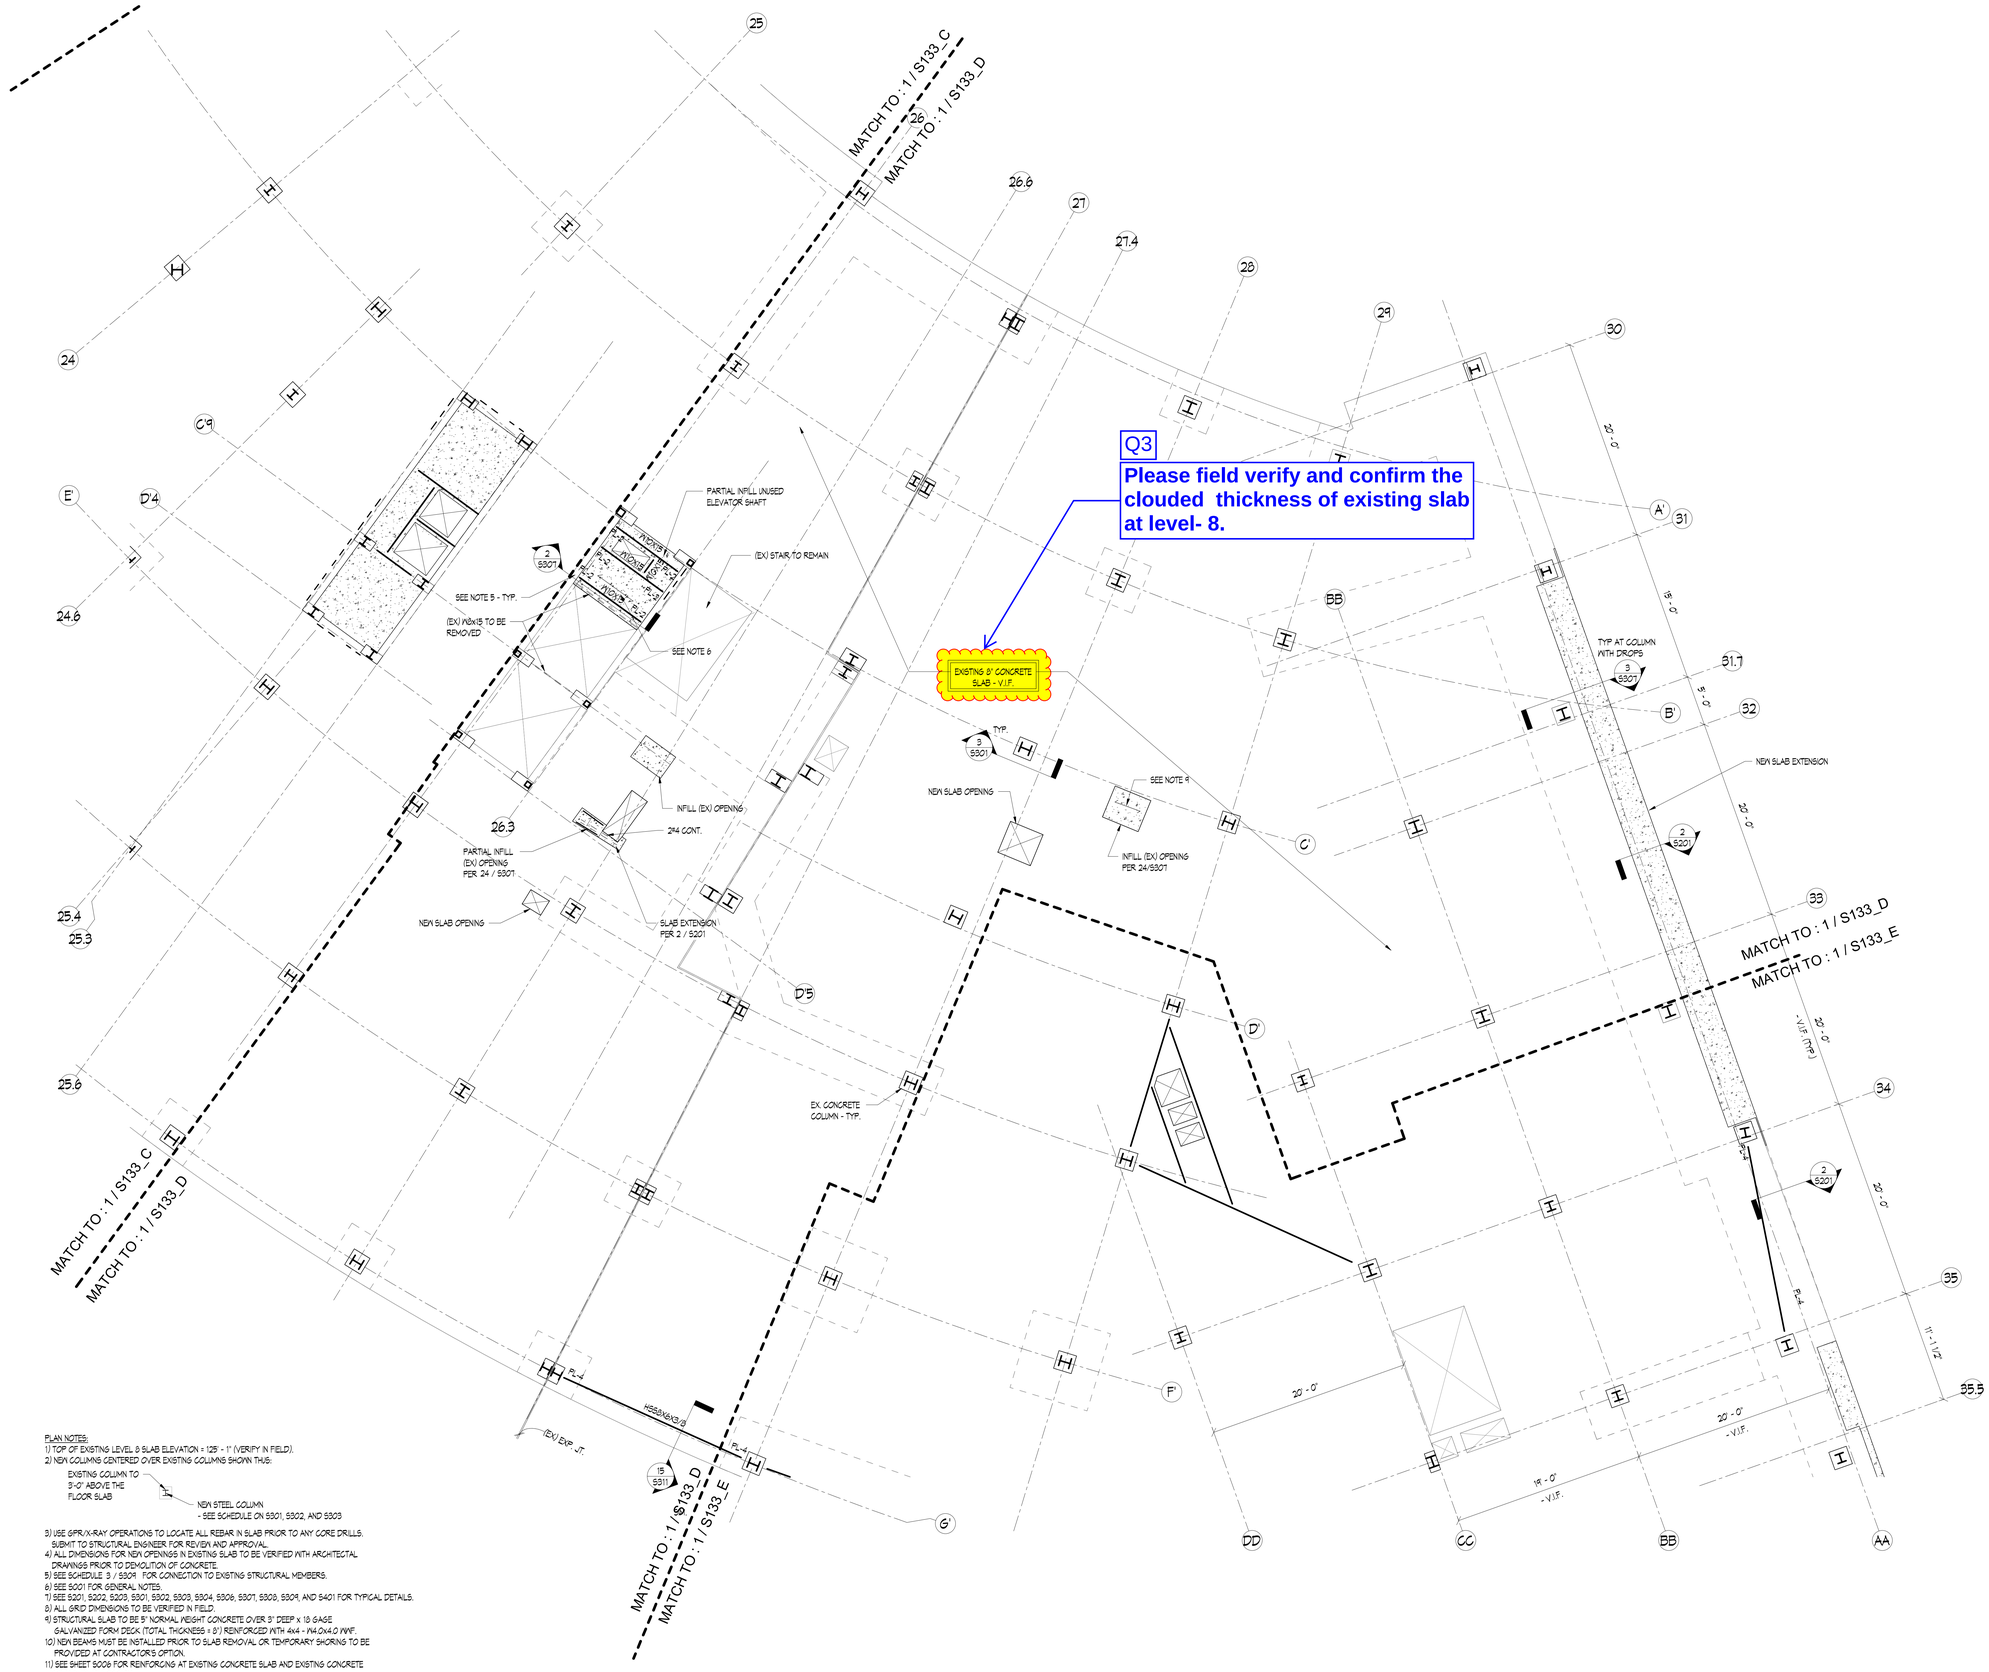

PLAN NOTES:
1) TOP OF EXISTING LEVEL 8 SLAB ELEVATION = 125' - 1" (VERIFY IN FIELD).
2) NEW COLUMNS CENTERED OVER EXISTING COLUMNS SHOWN THUS:


NEW STEEL COLUMN - SEE SCHEDULE ON S301, S302, AND S303

3) USE GPR/X-RAY OPERATIONS TO LOCATE ALL REBAR IN SLAB PRIOR TO ANY CORE DRILLS. SUBMIT TO STRUCTURAL ENGINEER FOR REVIEW AND APPROVAL.
4) ALL DIMENSIONS FOR NEW OPENINGS IN EXISTING SLAB TO BE VERIFIED WITH ARCHITECTAL DRAWINGS PRIOR TO DEMOLITION OF CONCRETE.
5) SEE SCHEDULE 3 / S304 FOR CONNECTION TO EXISTING STRUCTURAL MEMBERS.
6) SEE S001 FOR GENERAL NOTES.
7) SEE S201, S202, S203, S301, S302, S303, S304, S306, S307, S308, S309, AND S401 FOR TYPICAL DETAILS.
8) ALL GRID DIMENSIONS TO BE VERIFIED IN FIELD.
10) NEW BEAMS MUST BE INSTALLED PRIOR TO SLAB REMOVAL OR TEMPORARY SHORING TO BE PROVIDED AT CONTRACTOR'S OPTION.
11) SEE SHEET S006 FOR REINFORCING AT EXISTING CONCRETE SLAB AND EXISTING CONCRETE COLUMN WHERE OCCURS.

1 PARTIAL LEVEL 08 FRAMING PLAN - ZONE D
SCALE: 3/16" = 1'-0"

03 page of 06

DOB STAMP

1250 Maryland Avenue
1250 MARYLAND AVENUE SW
WASHINGTON, DC 20024

BEYER BLINDER BELLE
3307 M Street Northwest, Suite 301
Washington, DC, 20007
202 333 8000

MECHANICAL & PLUMBING
HURST ENGINEERS
703-534-7872

ELECTRICAL
POWER DESIGN INC.
727-497-9811

STRUCTURAL
RATHGEBBER GOSS ASSOCIATES
301-590-0071

CIVIL
GORDON DC
202-869-1600

LANDSCAPE
OVS
202-546-7575

INTERIORS
KTGY SDDG
312-274-0707

LIGHTING
CM KLING + ASSOCIATES
703-684-6270

KEY PLAN

STAMP

NO	DATE	DESCRIPTION
4	02/14/2025	50% CD ADDENDUM 4
3	01/24/2025	50% CD ADDENDUM 3
1	12/13/2024	50% CD ADDENDUM 1

REVISIONS

SUBMITTAL
85% CONSTRUCTION DOCUMENTS

DRAWING TITLE
PARTIAL LEVEL 08
FRAMING PLAN - ZONE D

SCALE	As indicated
DATE	01/24/25
PROJECT NUMBER	6415.00

DRAWING NUMBER
S133_D
of

Q4

Please field verify and confirm if the green clouded existing concrete column skew/orientation is parallel to grid 23.

Q5

Please field verify and confirm if the orange clouded existing concrete column skew/ orientation is parallel to grid 24.

Q6

Please field verify and confirm if these brown clouded existing concrete columns skew/orientation are parallel to grid 26.

Q7

Please field verify and confirm if the magenta clouded 6-existing concrete columns skew/orientation are parallel to grid 26.6.

Q8

Please field verify and confirm if these purple clouded existing concrete columns skew/orientation are parallel to grid 28.

Q9

Please field verify and confirm if these cyan clouded existing concrete columns skew/orientation are parallel to grid 27.4.

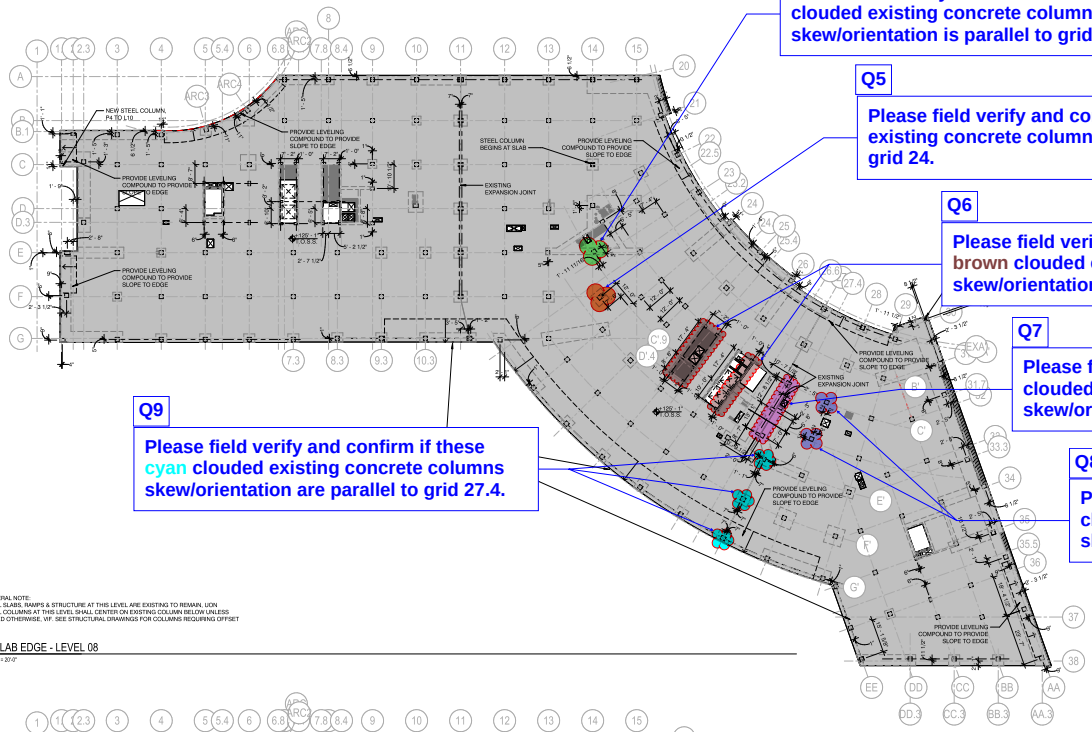

GENERAL NOTE:
1) ALL SLABS, RAMPS & STRUCTURE AT THIS LEVEL ARE EXISTING TO REMAIN, UON
2) ALL COLUMNS AT THIS LEVEL SHALL CENTER ON EXISTING COLUMN BELOW UNLESS NOTED OTHERWISE, VIF. SEE STRUCTURAL DRAWINGS FOR COLUMNS REQUIRING OFFSET

2 A056 SLAB EDGE - LEVEL 08
1" = 20'-0"

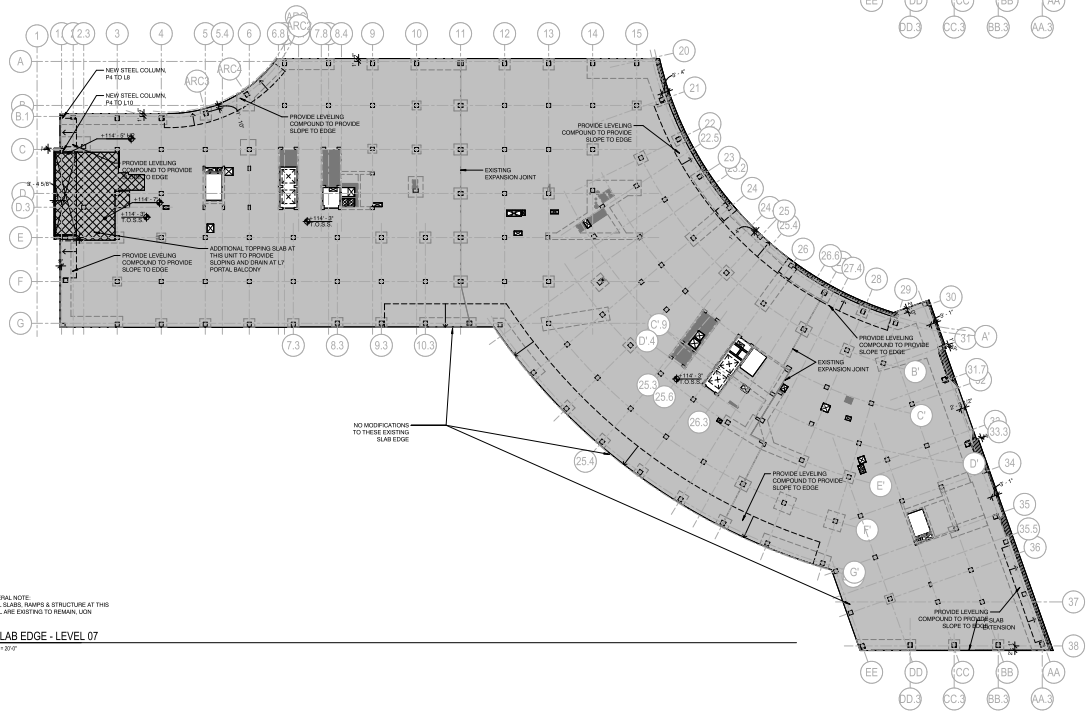

GENERAL NOTE:
1) ALL SLABS, RAMPS & STRUCTURE AT THIS LEVEL ARE EXISTING TO REMAIN, UON

1 A056 SLAB EDGE - LEVEL 07
1" = 20'-0"

SLAB EDGE DRAWING NOTES:

1. SLAB DRAWINGS ARE BASED ON EXISTING DRAWINGS. ALL DIMENSIONS TO BE VERIFIED IN FIELD.
2. SEE DEMOLITION DRAWINGS FOR NEW OPENINGS, STRUCTURAL DEMOLITION, AND SLAB EDGES THAT ARE TO BE CUT BACK.
3. SEE ADDITIONAL NOTES ON DEMOLITION DRAWINGS FOR ELEVATOR PITS IN PARKING GARAGE.
4. NEW INFILLS AT OPENINGS AND SLAB EXTENSIONS ARE TO MATCH ADJACENT SLAB LEVEL UNLESS NOTED OTHERWISE.

LEGEND:
- EXISTING SLAB, TO REMAIN
- NEW SLAB, INFILL
- NEW SLAB, DOWEL
- NEW SLAB, CONC ON METAL DECK
- NEW CONCRETE TOPPING FILL
- COLUMN DROP OR BEAM BELOW

DOB STAMP

1250 Maryland Avenue
1250 MARYLAND AVENUE SW
WASHINGTON, DC 20024

BEYER BLINDER BELLE
3307 M Street Northwest, Suite 301
Washington, DC, 20007
202 333 8000

MECHANICAL & PLUMBING
HURST ENGINEERS
703-534-7872

ELECTRICAL
POWER DESIGN INC.
727-497-9811

STRUCTURAL
...ER GOSS ASSOCIATES
...071

CIVIL
...DC
...500

CIVIL
202-546-7575

INTERIORS
KTGY SDDG
312-274-0707

LIGHTING
CM KLING + ASSOCIATES
703-684-6270

KEY PLAN

STAMP

NO	DATE	DESCRIPTION

REVISIONS

SUBMITTAL

ASK -002 a
PRE-IFC RFI 14
2-6-25

DRAWING TITLE

SLAB EDGE - LEVEL 07 TO 08

SCALE	As indicated
DATE	11/8/2024
PROJECT NUMBER	6415.00

DRAWING NUMBER

A056

Q10

At the clouded location, please provide existing concrete column size at below level-8 slab.

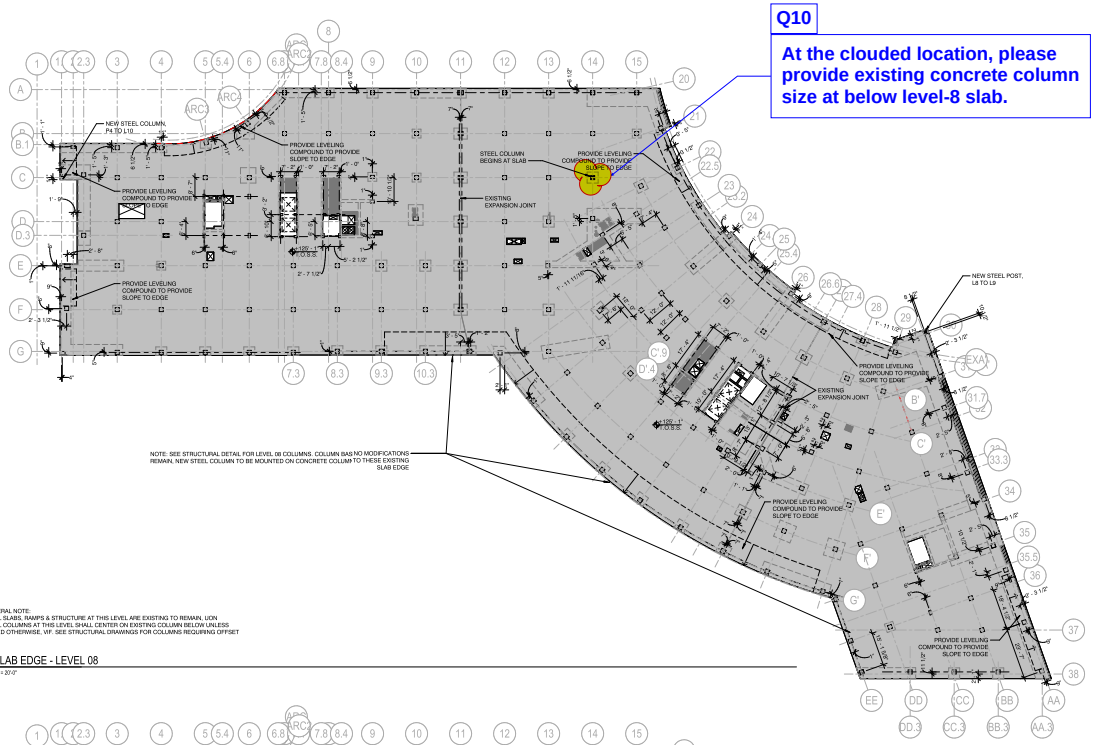

GENERAL NOTE:
1) ALL SLABS, RAMPS & STRUCTURE AT THIS LEVEL ARE EXISTING TO REMAIN, UON
2) ALL COLUMNS AT THIS LEVEL SHALL CENTER ON EXISTING COLUMN BELOW UNLESS NOTED OTHERWISE, VIF. SEE STRUCTURAL DRAWINGS FOR COLUMNS REQUIRING OFFSET

2 A056 SLAB EDGE - LEVEL 08
1" = 20'-0"

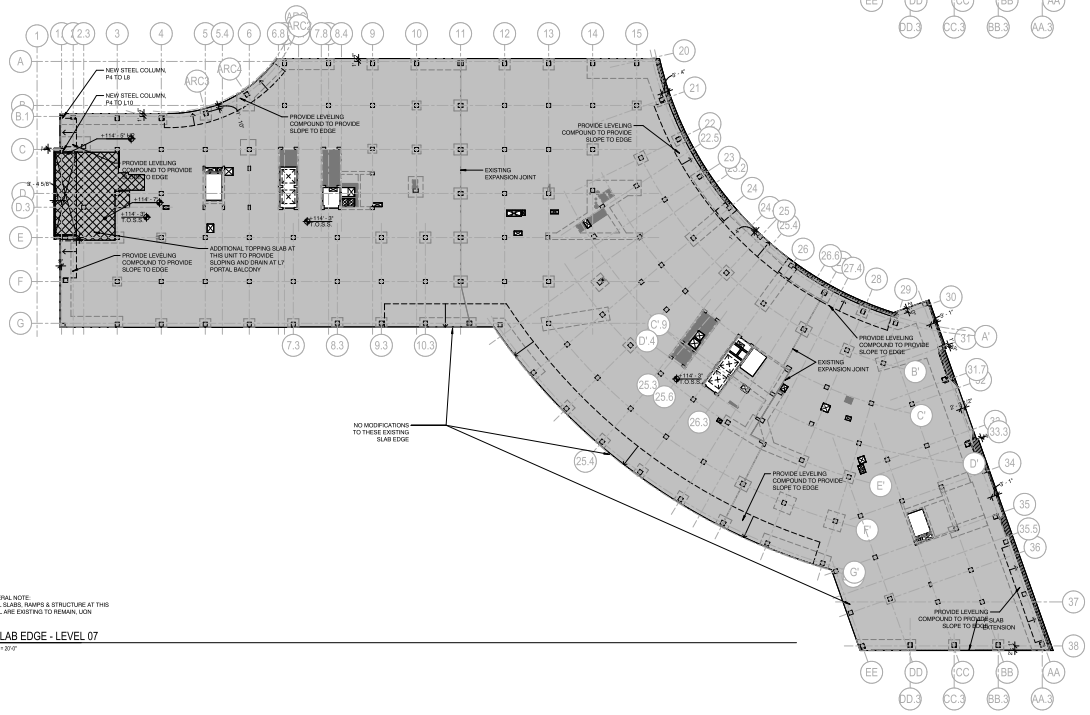

GENERAL NOTE:
1) ALL SLABS, RAMPS & STRUCTURE AT THIS LEVEL ARE EXISTING TO REMAIN, UON

1 A056 SLAB EDGE - LEVEL 07
1" = 20'-0"

SLAB EDGE DRAWING NOTES:

1. SLAB DRAWINGS ARE BASED ON EXISTING DRAWINGS. ALL DIMENSIONS TO BE VERIFIED IN FIELD.
2. SEE DEMOLITION DRAWINGS FOR NEW OPENINGS, STRUCTURAL DEMOLITION, AND SLAB EDGES THAT ARE TO BE CUT BACK.
3. SEE ADDITIONAL NOTES ON DEMOLITION DRAWINGS FOR ELEVATOR PITS IN PARKING GARAGE.
4. NEW INFILLS AT OPENINGS AND SLAB EXTENSIONS ARE TO MATCH ADJACENT SLAB LEVEL UNLESS NOTED OTHERWISE.

LEGEND:
- EXISTING SLAB, TO REMAIN
- NEW SLAB, INFILL
- NEW SLAB, DOWEL
- NEW SLAB, CONC ON METAL DECK
- NEW CONCRETE TOPPING FILL
- COLUMN DROP OR BEAM BELOW

DOB STAMP

1250 Maryland Avenue
1250 MARYLAND AVENUE SW
WASHINGTON, DC 20024

BEYER BLINDER BELLE
3307 M Street Northwest, Suite 301
Washington, DC, 20007
202 333 8000

MECHANICAL & PLUMBING
HURST ENGINEERS
703-534-7872

ELECTRICAL
POWER DESIGN INC.
727-497-9811

STRUCTURAL
RATHGEBER GOSS ASSOCIATES
301-590-0071

CIVIL
GORDON DC
202-869-1600

LANDSCAPE
OVS
202-546-7575

INTERIORS
KTGY SDDG
312-274-0707

LIGHTING
CM KLING + ASSOCIATES
703-684-6270

KEY PLAN

STAMP

NO	DATE	DESCRIPTION

REVISIONS

SUBMITTAL

ASK -002 a
PRE-IFC RFI 14
2-6-25

DRAWING TITLE

SLAB EDGE - LEVEL 07 TO 08

SCALE	As indicated
DATE	11/8/2024
PROJECT NUMBER	6415.00

DRAWING NUMBER

A056

Q11

Please field measure and provide all yellow clouded ?? dimensions for center of existing concrete column to grid.

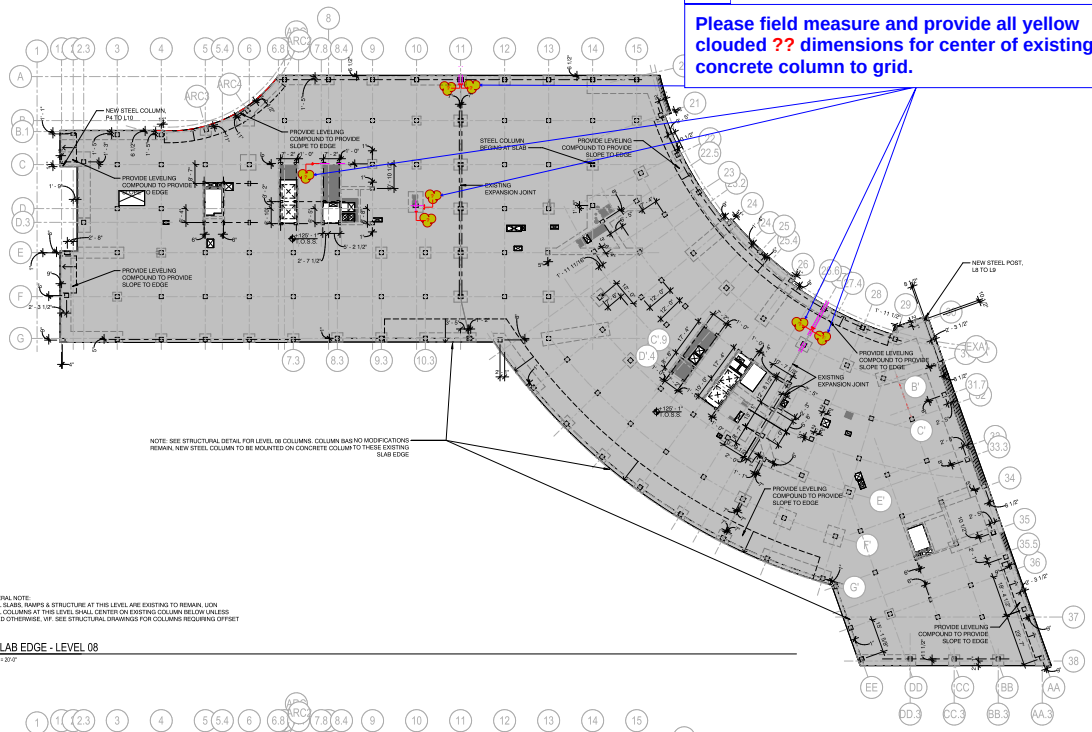

GENERAL NOTE:
1) ALL SLABS, RAMPS & STRUCTURE AT THIS LEVEL ARE EXISTING TO REMAIN, UON
2) ALL COLUMNS AT THIS LEVEL SHALL CENTER ON EXISTING COLUMN BELOW UNLESS NOTED OTHERWISE, VIF. SEE STRUCTURAL DRAWINGS FOR COLUMNS REQUIRING OFFSET

2 A056 SLAB EDGE - LEVEL 08
1" = 20'-0"

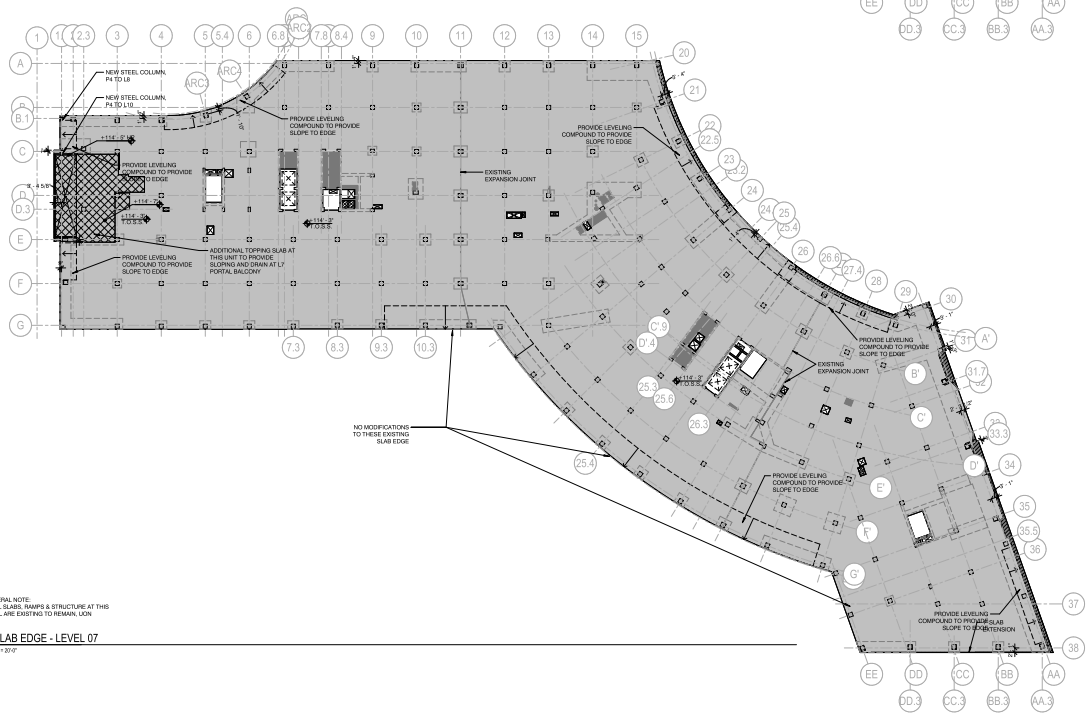

GENERAL NOTE:
1) ALL SLABS, RAMPS & STRUCTURE AT THIS LEVEL ARE EXISTING TO REMAIN, UON

1 A056 SLAB EDGE - LEVEL 07
1" = 20'-0"

SLAB EDGE DRAWING NOTES:

1. SLAB DRAWINGS ARE BASED ON EXISTING DRAWINGS. ALL DIMENSIONS TO BE VERIFIED IN FIELD.
2. SEE DEMOLITION DRAWINGS FOR NEW OPENINGS, STRUCTURAL DEMOLITION, AND SLAB EDGES THAT ARE TO BE CUT BACK.
3. SEE ADDITIONAL NOTES ON DEMOLITION DRAWINGS FOR ELEVATOR PITS IN PARKING GARAGE.
4. NEW INFILLS AT OPENINGS AND SLAB EXTENSIONS ARE TO MATCH ADJACENT SLAB LEVEL UNLESS NOTED OTHERWISE.

LEGEND:
- EXISTING SLAB, TO REMAIN
- NEW SLAB, INFILL
- NEW SLAB, DOWEL
- NEW SLAB, CONC ON METAL DECK
- NEW CONCRETE TOPPING FILL
- COLUMN DROP OR BEAM BELOW

DOB STAMP

1250 Maryland Avenue
1250 MARYLAND AVENUE SW
WASHINGTON, DC 20024

BEYER BLINDER BELLE
3307 M Street Northwest, Suite 301
Washington, DC, 20007
202 333 8000

MECHANICAL & PLUMBING
HURST ENGINEERS
703-534-7872

ELECTRICAL
POWER DESIGN INC.
727-497-9811

STRUCTURAL
RATHGEBER GOSS ASSOCIATES
301-590-0071

CIVIL
GORDON DC
202-869-1600

LANDSCAPE
OVS
202-546-7575

INTERIORS
KTGY SDDG
312-274-0707

LIGHTING
CM KLING + ASSOCIATES
703-684-6270

KEY PLAN

STAMP

NO	DATE	DESCRIPTION

REVISIONS

SUBMITTAL

ASK -002 a
PRE-IFC RFI 14
2-6-25

DRAWING TITLE

SLAB EDGE - LEVEL 07 TO 08

SCALE	As indicated
DATE	1/18/2024
PROJECT NUMBER	6415.00

DRAWING NUMBER

A056